

Name **Louis Mariette**

Service No. **#3567**  
**3291**

Address ~~XXXXXXXXXXXXXXXXXXXX~~ **4 Winship Road**

**Lexington, Mass.**

Location ~~XXXXXXXXXXXXXXXXXXXX~~

Kind of Pipe

Size

Size of Main

~~XXXXXXXXXXXX~~ **New Service**

Location

Date	Material	Amount	Total	Date	Amount
June 25, '47	Labor	25 30	25 30	June 25 '47	80 00
	10% Overhead		2 53	Sept 25 '47	34 47
	40' - 3/4" Copper Tubing @.27		10 80		42 53
	1 - 3/4" C x 1/2" I.W.H. S & W		3 15	June 24, '47	8 87
	Trucking 1 hr. @.75		75	25	10 30
			<u>42 53</u>	9' - 3/4" Copper Tubing @.27	2 43
				1 - 3/4" C Corp-cock	3 00
				1 - 3/4" C x 3/4" C Curb-cock	3 68
				1 - Box & Rod	4 26
				1 - 1/2" Straight Tail Piece	30
				1 - 1/2" Offset Tail Piece	30
				Trucking 1 hr. @.75	75
	Labor				<u>33 39</u>

Hadley Press, Inc., Lexington

DATE \_\_\_\_\_

# TOWN OF LEXINGTON—BOARD OF PUBLIC WORKS

## WATER DIVISION

The undersigned applies for a supply of water at No. \_\_\_\_\_ St. and hereby agrees to comply with the rules and regulations as now, or at any future time, established by the Board of Selectmen.

Am't. of Estimate \$ \_\_\_\_\_


Owner \_\_\_\_\_

Am't. Paid \$ \_\_\_\_\_

Address \_\_\_\_\_

Builder \_\_\_\_\_

Sketch of Service Here

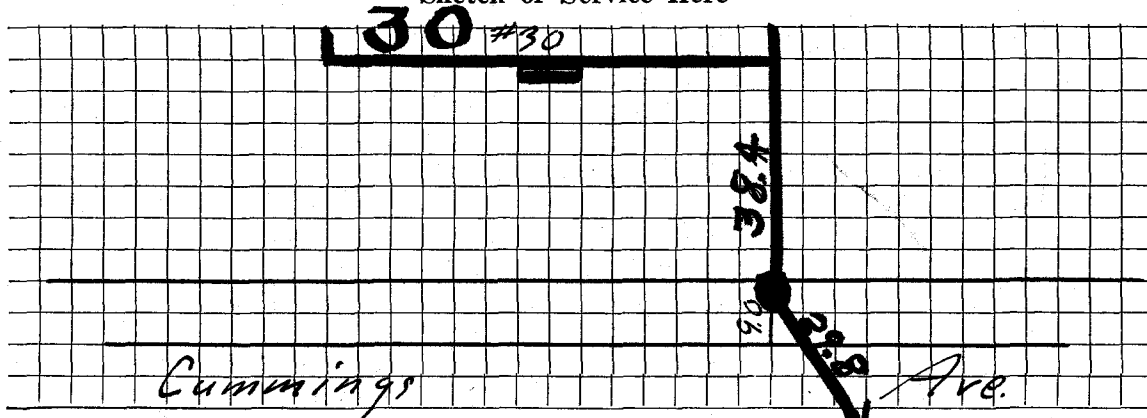

Connection made in \_\_\_\_\_ Street.

Work completed \_\_\_\_\_ 19

Remarks: