

Name MacLane Incorporated

Service No. 258

Address 3 Winston Road

# 6349

Lexington, Mass.

Locatio 3 Winston Road

Kind of Pipe

Size

Size of Main

~~REPAIR~~ ~~REPAIR~~ New Service

Com. 11-6-50

Location

Date	Material	Amount	Total	Date	Location	Amount
Sept. 7, '50	Labor	1 30	1 30	Aug 21 '50	Deposited	15 00
	10% Overhead		13			
	1 - 3/4" C x 1/2" I.W.H S&W		3 29		No Charge	5 47
	Trucking 1 hr. @.75		75	Sept. 7, '50	Labor	2 60
	Pipe supplied & laid by owner		5 47	30' - 3/4" Copper Tubing @.275		8 25
				1 - 3/4" C Corp-cock		3 15
				1 - 3/4" C x 3/4" C Curb-cock		3 85
				1 - Box & Rod		3 35
				1 - 1/2" Offset Tail Piece		42
				1 - 1/2" Straight Tail Piece		42
				Littlefield Shovel 3 hrs. @7.00		21 00
				Trucking 1 hr. @.75		75
	Labor					43 79

Hadley Press, Inc., Lexington

DATE \_\_\_\_\_

# TOWN OF LEXINGTON—BOARD OF PUBLIC WORKS

## WATER DIVISION

The undersigned applies for a supply of water at No. \_\_\_\_\_ St. and hereby agrees to comply with the rules and regulations as now, or at any future time, established by the Board of Selectmen.

Am't. of Estimate \$ \_\_\_\_\_


Owner \_\_\_\_\_

Am't. Paid \$ \_\_\_\_\_

Address \_\_\_\_\_

Builder \_\_\_\_\_

Sketch of Service Here

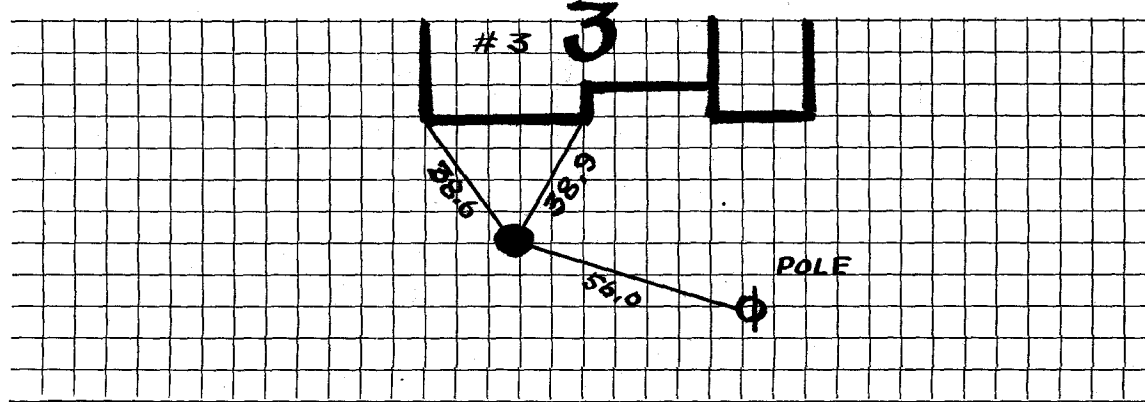

Connection made in \_\_\_\_\_ Street.

Work completed \_\_\_\_\_ 19

Remarks: