

Name MacLand Incorporated

Service No. 258

Address 4 Winston Road

#242

Lexington, Mass.

Locatic 4 Winston Road

Kind of Pipe

Size

Size of Main

~~Repair-Renewal~~—New Service

Com. 11-6-50

Location

Date	Material	Amount	Total	Date	Location	Amount
Aug. 21, '50	Labor	1 50	1 50	Aug 21 '50	<i>Deposited</i> <i>Card</i>	15 00
	10% Overhead		15	Dec 1 '50		69
	36' - 3/4" Copper Tubing @.275		9 90		No Charge	15 59
	1 - 3/4" C x 1/2" I.W.H. S&W		3 29	Aug. 21, '50	Labor	8 70
	Trucking 1 hr. @.75		75	9' - 3/4" Copper Tubing @.275		2 48
			15 59	1 - 3/4" C Corp-cock		3 15
				1 - 3/4" C x 3/4" C Curb-cock		3 85
				1 - Box & Rod		3 35
				1 - 1/2" Offset Tail Piece		42
				1 - 1/2" Straight Tail Piece		42
				Trucking 1 hr. @.75		75
	Labor					23 42

Hadley Press, Inc., Lexington

DATE _____

TOWN OF LEXINGTON—BOARD OF PUBLIC WORKS

WATER DIVISION

The undersigned applies for a supply of water at No. _____ St. and hereby agrees to comply with the rules and regulations as now, or at any future time, established by the Board of Selectmen.

Am't. of Estimate \$ _____


Owner _____

Am't. Paid \$ _____

Address _____

Builder _____

Sketch of Service Here

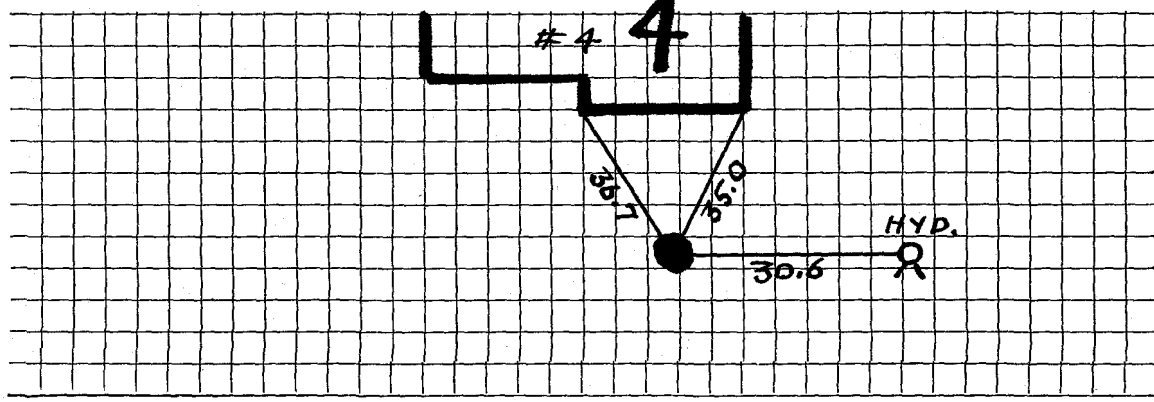

Connection made in _____ Street.

Work completed _____ 19

Remarks: