

Name MacLand Incorporated

Service No.

258 #4494

Address 5 Winston Road

#4085

Lexington, Mass.

Locatio 5 Winston Road

Kind of Pipe

Size

Size of Main

~~XXXXXX~~ New Service

Com. 11-6-50

Location

Date

Material

Amount

Total

Date

Amount

Aug. 24, '50

Labor

1 50

1 50

Aug 21 '50

Deposited

13 00

10% Overhead

15

Dec 1 '50

Card

87

37' - 3/4" Copper Tubing @.275

10 18

No Charge

15 87

1 - 3/4"C x 1/2" I.W.H. S&W

3 29

Aug. 24, '50

Labor

11 70

Trucking 1 hr. @.75

75

29' - 3/4" Copper Tubing @.275

7 98

15 87

1 - 3/4"C Corp-cock

3 15

1 - 3/4"C x 3/4"C Curb-cock

3 85

1 - Box & Rpd

3 35

1 - 1/2" Offset Tail Piece

42

1 - 1/2" Straight Tail Piece

42

Trucking 1 hr. @.75

75

31 62

Labor

DATE _____

TOWN OF LEXINGTON—BOARD OF PUBLIC WORKS

WATER DIVISION

The undersigned applies for a supply of water at No. _____ St. and hereby agrees to comply with the rules and regulations as now, or at any future time, established by the Board of Selectmen.

Am't. of Estimate \$ _____


Owner _____

Am't. Paid \$ _____

Address _____

Builder _____

Sketch of Service Here

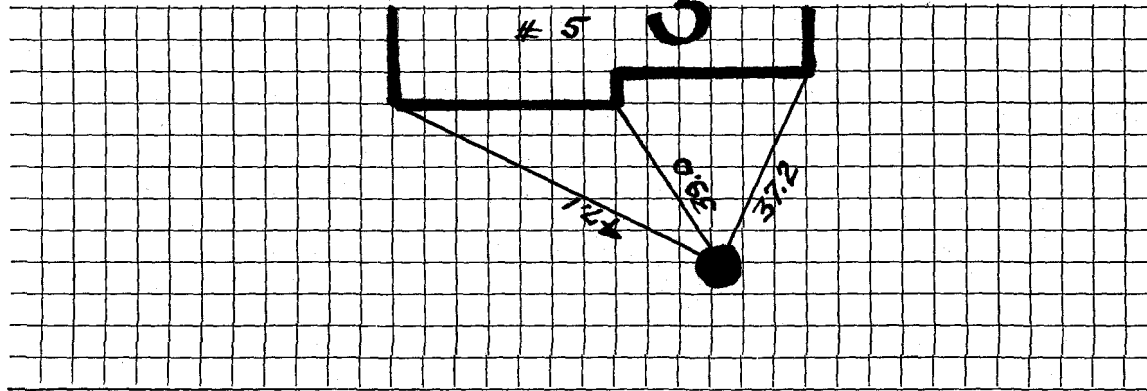

Connection made in _____ Street.

Work completed _____ 19

Remarks: