

Name MacLand Incorporated

Service No. 258

Address 7 Winston Road

#5704

Lexington, Mass.

Locatic 7 Winston Road

Kind of Pipe

Size

Size of Main

Repair—Renewal—New Service

Com. 11-6-50

Location

Date	Material	Amount	Total	Date	Amount
Aug. 21, '50	Labor	1 50	1 50	Aug 21 '50	15 00
	10% Overhead		15	Dec 1 '50	32
	35' - 3/4" Copper Tubing @.275		9 63		15 32
	1 - 3/4"C x 1/2" I.W.H. S&W		3 29		
	Trucking 1 hr. @.75		75		
			15 32		
				Aug. 24, '50	11 70
				36' - 3/4" Copper Tubing @.275	9 90
				1 - 3/4"C Corp-cock	3 15
				1 - 3/4"C x 3/4"C Curb-cock	3 85
				1 - Box & Rod	3 35
				1 - 1/2" Offset Tail Piece	42
				1 - 1/2" Straight Tail Piece	42
				Trucking 1 hr. @.75	75
					33 54
	Labor				

Deposited
Paid

No Charge

Hadley Press, Inc., Lexington

DATE _____

TOWN OF LEXINGTON—BOARD OF PUBLIC WORKS

WATER DIVISION

The undersigned applies for a supply of water at No. _____ St. and hereby agrees to comply with the rules and regulations as now, or at any future time, established by the Board of Selectmen.

Am't. of Estimate \$ _____


Owner _____

Am't. Paid \$ _____

Address _____

Builder _____

Sketch of Service Here

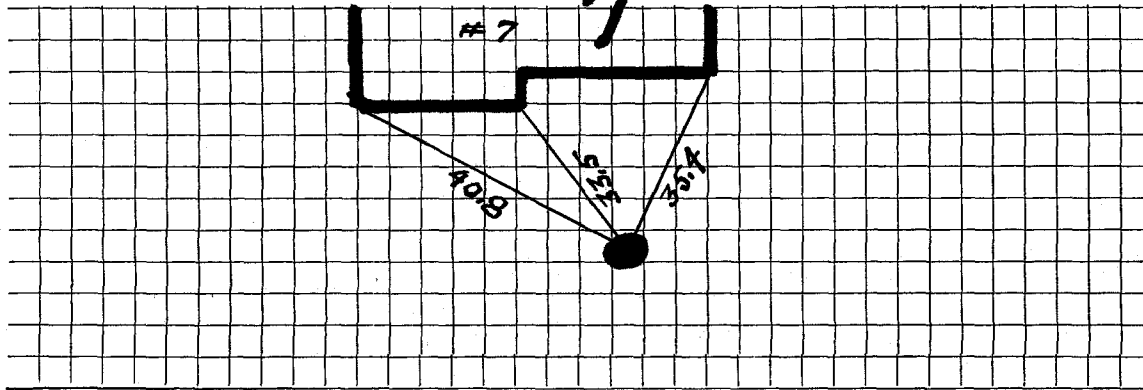

Connection made in _____ Street.

Work completed _____ 19

Remarks: