

Name MacLand Inc.

Service No. 258

Address 9 Winston Road

1981

Lexington, Mass.

Locatio 9 Winston Road

Kind of Pipe

Size

Size of Main

~~Repair~~ Renewal—New Service

Dom. 11-6-50

Location

Date	Material	Amount	Total	Date	Amount
Aug. 24, '50	Labor	1 50	1 50	Aug 21, '50	15 00
	10% Overhead		15	Dec 1 '50	5 25
	48' - 3/4" Copper Tubing @.275		13 20		20 28
	1 - 3/4"C x 1/2" I.W.H. S&W		3 29	Aug. 24, '50	11 70
	1 - 3/4"C x 3/4" Union (3pts)		1 39	37' - 3/4" Copper Tubing @.275	10 18
	Trucking 1 hr. @.75		75	1 - 3/4" Corp-cock	3 15
			20 28	1 - 3/4"C x 3/4" Curb-cock	3 85
				1 - Box & Rod	3 35
				1 - 1/8" Offset Tail Piece	42
				1 - 1/2" Straight Tail Piece	42
				Trucking 1 hr. @.75	75
					33 82
	Labor				

Deposited
Paid

No Charge

DATE _____

TOWN OF LEXINGTON—BOARD OF PUBLIC WORKS

WATER DIVISION

The undersigned applies for a supply of water at No. _____ St. and hereby agrees to comply with the rules and regulations as now, or at any future time, established by the Board of Selectmen.


Am't. of Estimate \$ _____

Owner _____

Am't. Paid \$ _____

Address _____

Builder _____

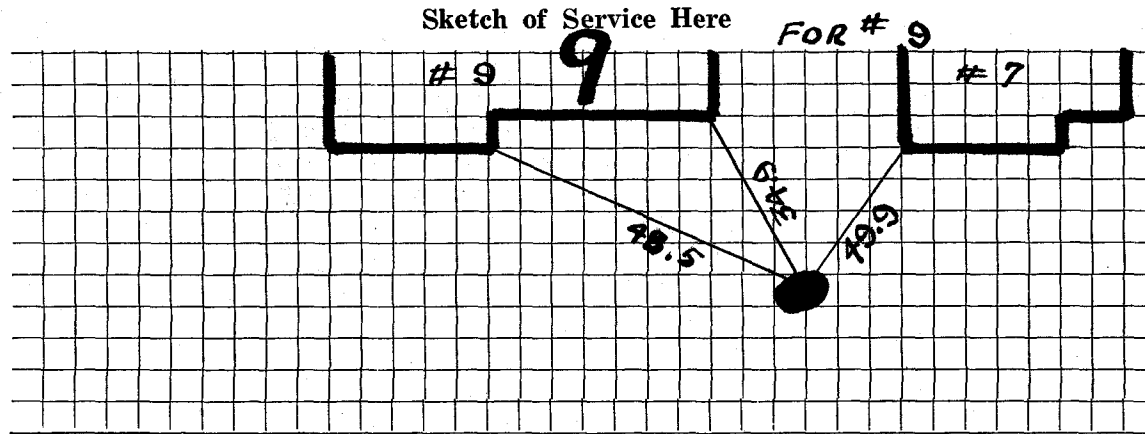

Connection made in _____ Street.

Work completed _____ 19

Remarks: