

WATER SERVICE RECORD

Name Joseph Benoit

Service No. 159

Address 100 Winter Street

Location Lexington, Mass.

# 2292


~~Repair-Replace~~ New Service Com. 10-1-51

Date	Material	Amount	Total	Date	Amount
8-3-51	Labor	2 76	2 76	7-13-51 Deposited	75 -
	10% Overhead		28	10-1-51 Refunded	8 82
	45' - 3/4" Copper Tubing @ .326	14 67			66 18
	1-3/4" Cx3/4" C Union (3 pts)	1 72		No Charge	
	1-3/4" C x 1/2 I.W.H. S&W	4 00		8-3-51 Labor	30 25
	2 Hrs. Littlefield Shovel	14 00		30' - 3/4" Copper Tubing @ .326	9 78
	1 Hr. Trucking	75		1-3/4" C. Corp Cock	4 33
	Patching 28 x 3	28 00		1-3/4" C x 3/4" C Curb Cock	4 67
		66 18		1 Box & Rod	4 68
				1-1/2 Offset Tail Piece	50
				1-1/2 Straight Tail Piece	50
				2 Hrs. Littlefield Shovel	14 00
				1 Hr. Trucking	75
					69 46

DATE \_\_\_\_\_

TOWN OF LEXINGTON — BOARD OF PUBLIC WORKS  
WATER DIVISION

Sketch of Service Here

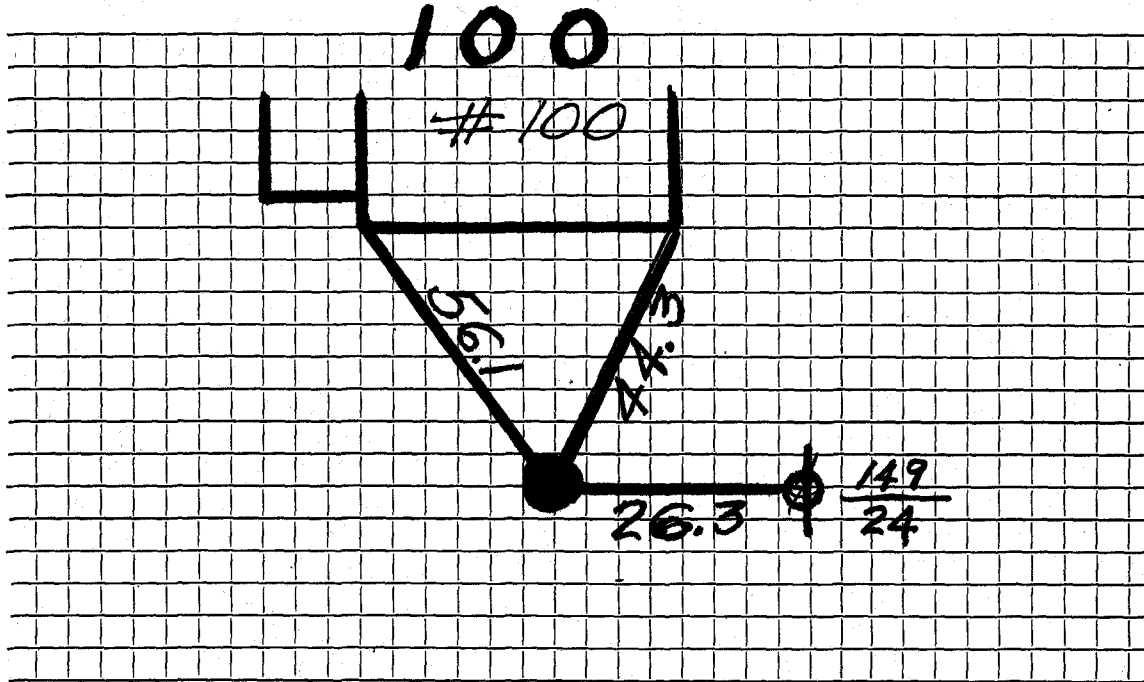

Connection made in ..... Street. Work completed .....

Remarks: .....

.....  
.....