

WATER SERVICE RECORD

Name John Joyce Realty Trust

Service No. 32

Address 101 Winter Street

Location

~~Renewal~~ ~~Renewal~~ New Service W.O. #6625 Dave Eagle #3343

NOV 13 1978


Date	Material	Amount	Total	Date	Amount
9-18-78	Labor	96.15		9-13-78	235.00
	10% O.H.	9.62	105.77		38.27
9'	1" Copper tubing @.90		8.10		196.73
1	1" Corp		17.86		
1	1" Curb		21.98		
1	Box & Rod		11.00		
1	hr. Trucking		3.00		
2	hrs. Backhoe @6.50		13.00		
	Hot Top 8' x 3'		16.02		
			196.73		
9-25-78	60' 1" Copper				

DATE \_\_\_\_\_

# TOWN OF LEXINGTON — BOARD OF PUBLIC WORKS

## WATER DIVISION

Sketch of Service Here

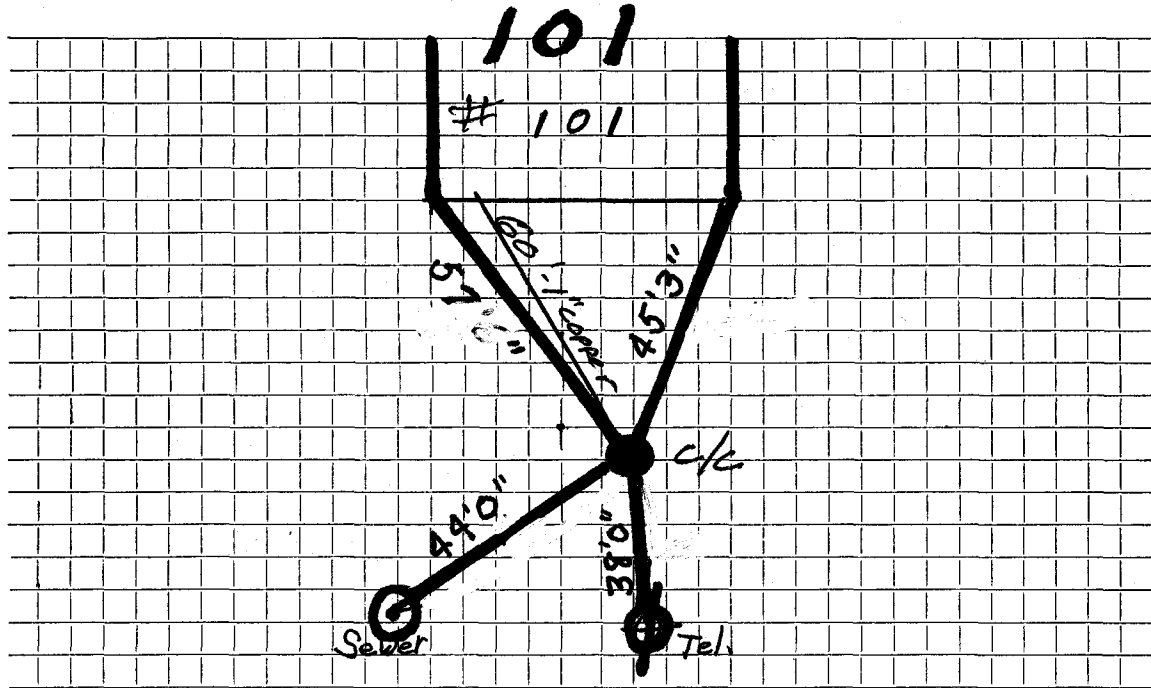

Connection made in ..... Street. Work completed .....

Remarks: .....  
.....  
.....