




DATE 11-30-2001

TOWN OF LEXINGTON — BOARD OF PUBLIC WORKS

WATER DIVISION

Sketch of Service Here

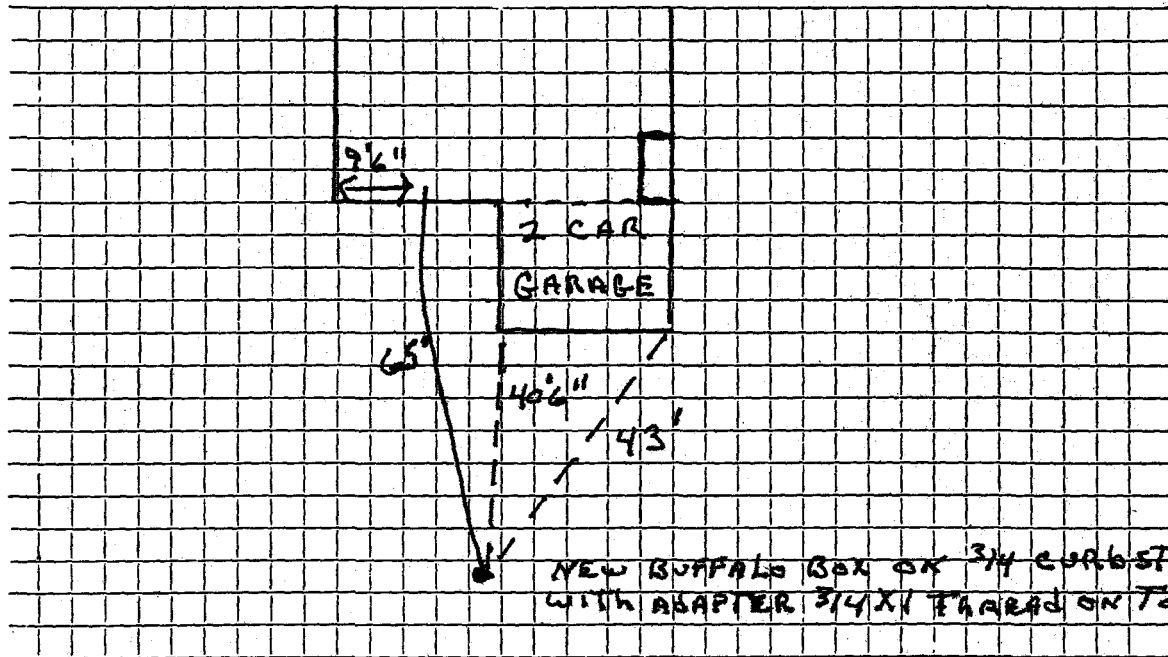

Connection made in ... WINTER ST. Street. Work completed ... 3-8-2001

Remarks: INSTALLED BY J. McLAUGHLIN