

Name Santi Shausheen

Service No.

193

Address 105 Winter Street

#3804

Lexington, Mass.

Location 105 Winter Street

Kind of Pipe

Size

Size of Main

~~Repair - Renewal~~ - New Service

Location

Date	Material	Amount	Total	Date	Amount
Sept. 11, '48	Labor	2 10	2 10	Sept 9 '48	15 00
	10% Overhead		21		23
	32'-3/4" Copper Tubing		8 16		14 37
	1-3/4" Cx 1/2" I.W.H. S & W		3 15	18'-3/4" Copper Tubing	4.59
	1 hr. Trucking		75	1-3/4" C. Corp Cock	3 00
			14 37	1-3/4" Cx 3/4" C. Curb Cock	3 68
				1-Box & Rod	3 55
				2-1/8" Offset Tail Pieces	60
				1 Hr. Trucking	75
	trench dug by owner.				16 17
	Labor				

Hadley Press, Inc., Lexington

Com. 10/25/48

Deposited
Non-Charge

DATE _____

TOWN OF LEXINGTON—BOARD OF PUBLIC WORKS

WATER DIVISION

The undersigned applies for a supply of water at No. _____ St. and hereby agrees to comply with the rules and regulations as now, or at any future time, established by the Board of Selectmen.

Am't. of Estimate \$ _____


Owner _____

Am't. Paid \$ _____

Address _____

Builder _____

Sketch of Service Here

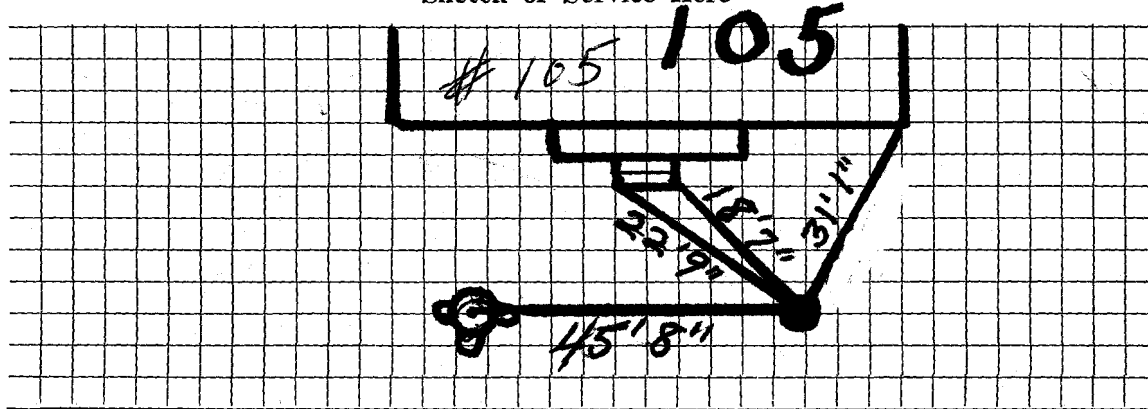

Connection made in _____ Street.

Work completed _____ 19

Remarks: