

Name Annette Spencer

Service No. 138 2967

Address 1 Winter Street, Lincoln, Mass.

Location 21 Winthrop Road

Kind of Pipe

Size

Size of Main

Repair—Renewal—New Service

Location

| Date 1941 | Material | Amount | Total | Date | Amount |
|--------------|----------------------------|--------|-------|------------------|--------|
| Nov. 8 | 51 hrs. @ 50¢ | 25 50 | | November 5, 1941 | 76 00 |
| Com 17/2/41 | 19 " @ 60¢ | 11 40 | | Dec 30 1941 | 3 01 |
| | 2 " @ 65¢ | 1 30 | 38 20 | | |
| | 10% Overhead | | 3 82 | | |
| | 76' 1" Copper tubing @ 22¢ | | 16 72 | | |
| | 1 1" C.x 3/4" I.S.& W. | | 2 50 | | |
| | 1 1" C.Union (3 parts) | | 1 25 | | |
| | 4 hrs. compressor @ 2.25 | | 9 00 | | |
| | 2 " trucking @ 75¢ | | 1 50 | | |
| | | | 72 99 | | |
| | Labor | | | | |

Deposited
Refund

72 99

Hadley Press, Inc., Lexington

76'

DATE Nov. 5. 1947

TOWN OF LEXINGTON—BOARD OF PUBLIC WORKS

WATER DIVISION

The undersigned applies for a supply of water at No. 21 Winthrop Rd St. and hereby agrees to comply with the rules and regulations as now, or at any future time, established by the Board of Selectmen.

Am't. of Estimate \$ 76⁰⁰

Owner Annette S. Spencer


Am't. Paid \$ _____

Address 1 Winter Street

Builder _____

Lincoln

Sketch of Service Here

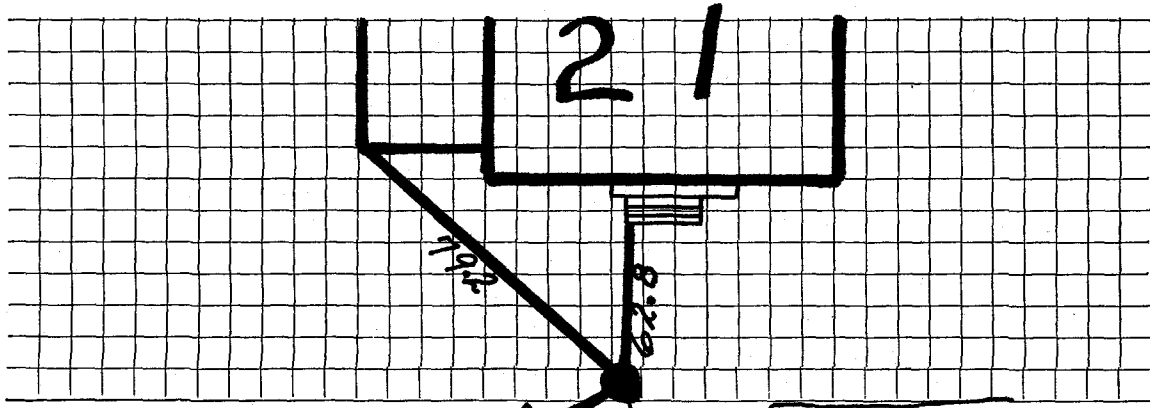

Connection made in _____

Remarks:

Street

Work completed _____

19

Richard
AVE