

WATER SERVICE RECORD

Name

Service No.

Address 34 WINTER ST.

Location

Repair—Renewal—New Service OJ P45005 #91-10


Date	Description	Amount	Total	Date	Description	Amount
9-29-92	OUTSIDE 31 LF 1" COPPER			8-13-34	100' 3/4" COPPER	
	1" CURB W/RED.				1 3 PART UNION	
	1" CORP.				3/4 S + W	
	SI					

DATE _____

TOWN OF LEXINGTON — BOARD OF PUBLIC WORKS

WATER DIVISION

Sketch of Service Here **34**

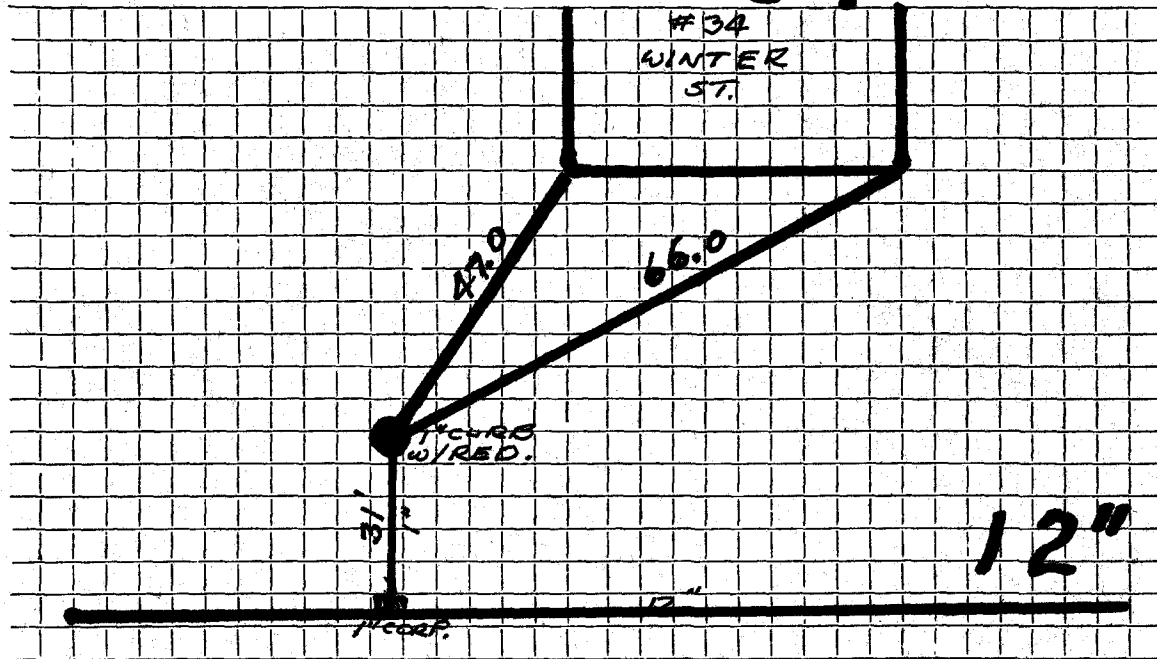

Connection made in WINTER Street. Work completed

Remarks: 3/4\" INSIDE