

WATER SERVICE RECORD

Name BOB WHELAN

Service No.

Address #44 WINTER STREET

Location

Repair Renewal New Service PERMIT NO. 0933 - SEAN TOCCI EXCAVATION


Date	Material	Amount	Total	Date	Amount
3/20/1997	61.2' - 1" ϕ COPPER				
				9-30-'92	
				21' 1" Copper	
				1 1" C. Corp Cock	
				1 1" C. Curb w/Reducer	

DATE MARCH 20, 1997

TOWN OF LEXINGTON — BOARD OF PUBLIC WORKS

WATER DIVISION

Sketch of Service Here

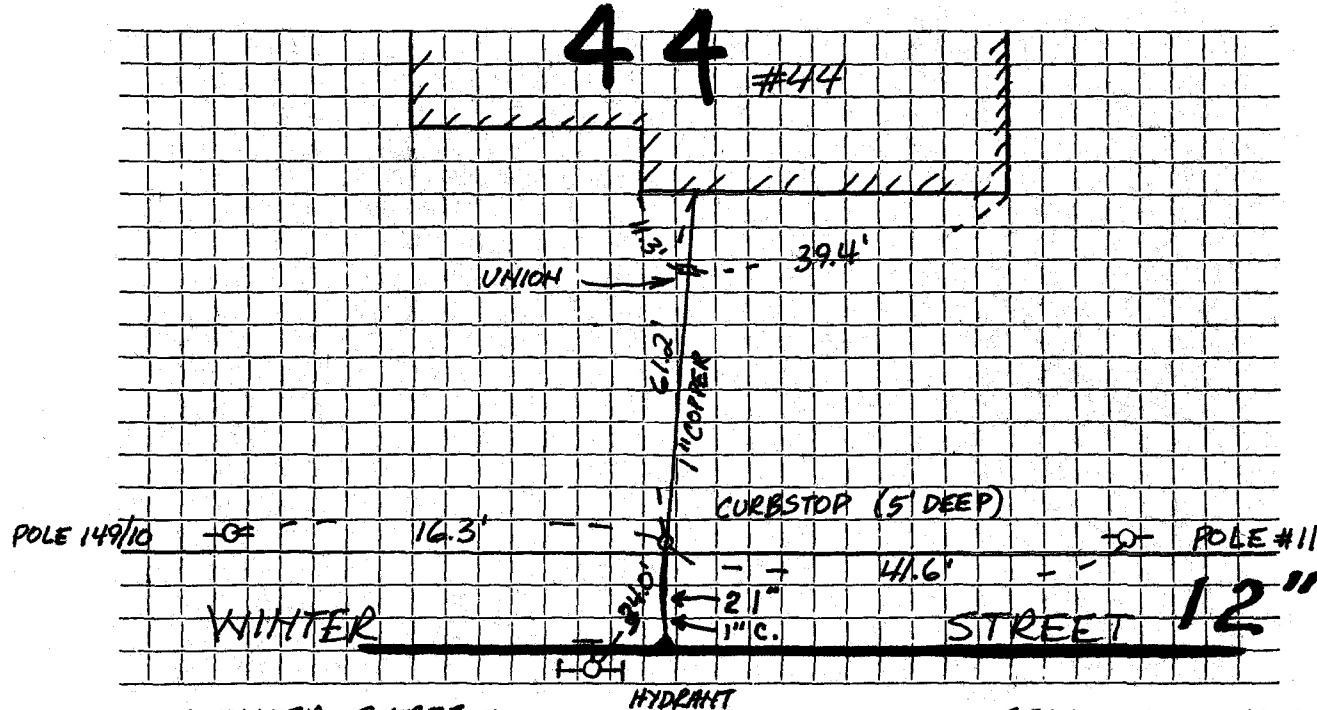

Connection made in ... WINTER STREET ... Street. Work completed SEAN TOCCI EXCAVATION

Remarks: