


TOWN OF LEXINGTON — BOARD OF PUBLIC WORKS

WATER DIVISION

Sketch of Service Here

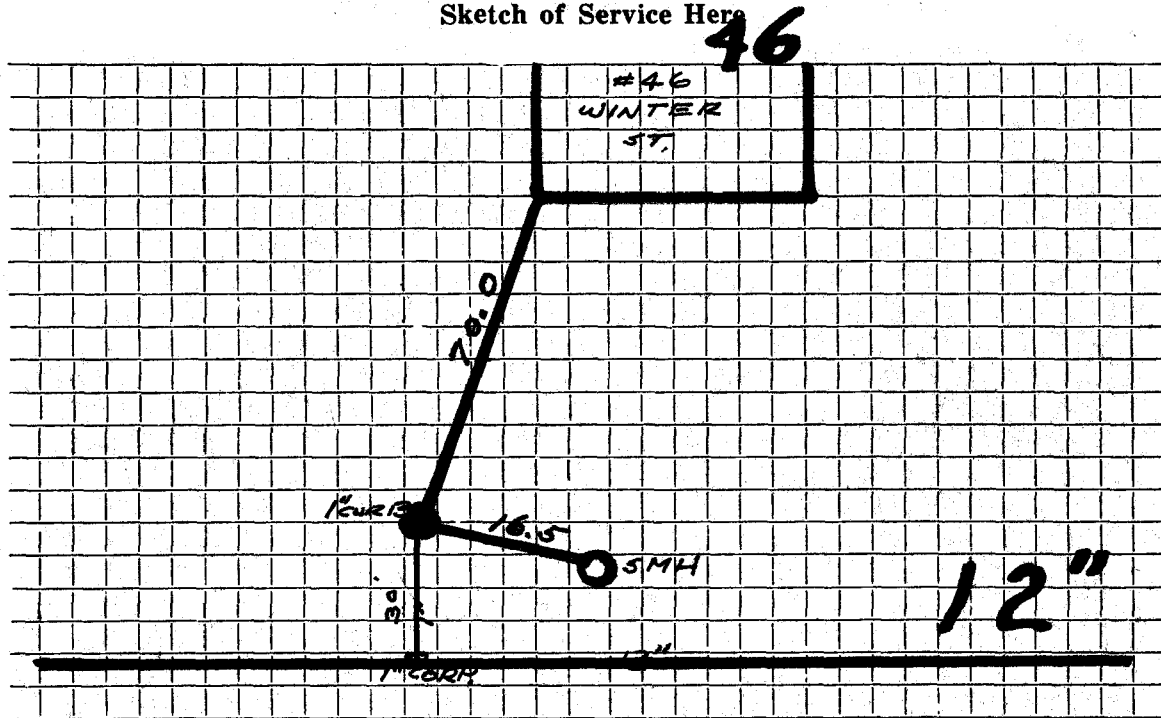

Connection made in WINTER Street. Work completed

Remarks: 1" COPPER INSIDE