

Name David Brewster

Service No. 181

Address 60 Winter Street

Lexington, Mass.

Location 60 Winter Street

Kind of Pipe

Size

Size of Main

Repair - Renewal - New Service

Com. 11-6-50

Location

Date	Material	Amount	Total	Date	Amount
Aug. 16, '50	Labor	3 80	3 80	July 24 '50	60 00
	10% Overhead		38		
	36' - 3/4" Copper Tubing @.275		9 90		
	1 - 3/4"C x 1/2" I.W.H. S&W		3 29		
	Littlefield Shovel 2 hrs. @7.00		14 00	Aug. 16, '50	7 40
	Trucking 1 hr. @.75		75	22' - 3/4" Copper Tubing @.275	6 05
	Patching 18 x 3		18 00	1 - 3/4"C Corp-cock	3 15
			50 12	1 - 3/4"C x 3/4"C Curb-cock	3 85
				1 - Box & Rod	3 35
				1 - 1/8" Offset Tail Piece	42
				1 - 1/2" Straight Tail Piece	42
				Littlefield Shovel 2 hrs. @ 7.00	14 00
				Trucking 1 hr. @.75	75
	<b>Labor</b>				<u>39 39</u>

Hadley Press, Inc., Lexington

*Deposited*

No Charge

DATE \_\_\_\_\_

# TOWN OF LEXINGTON—BOARD OF PUBLIC WORKS

## WATER DIVISION

The undersigned applies for a supply of water at No. \_\_\_\_\_ St. and hereby agrees to comply with the rules and regulations as now, or at any future time, established by the Board of Selectmen.

Am't. of Estimate \$ \_\_\_\_\_


Owner \_\_\_\_\_

Am't. Paid \$ \_\_\_\_\_

Address \_\_\_\_\_

Builder \_\_\_\_\_

Sketch of Service Here

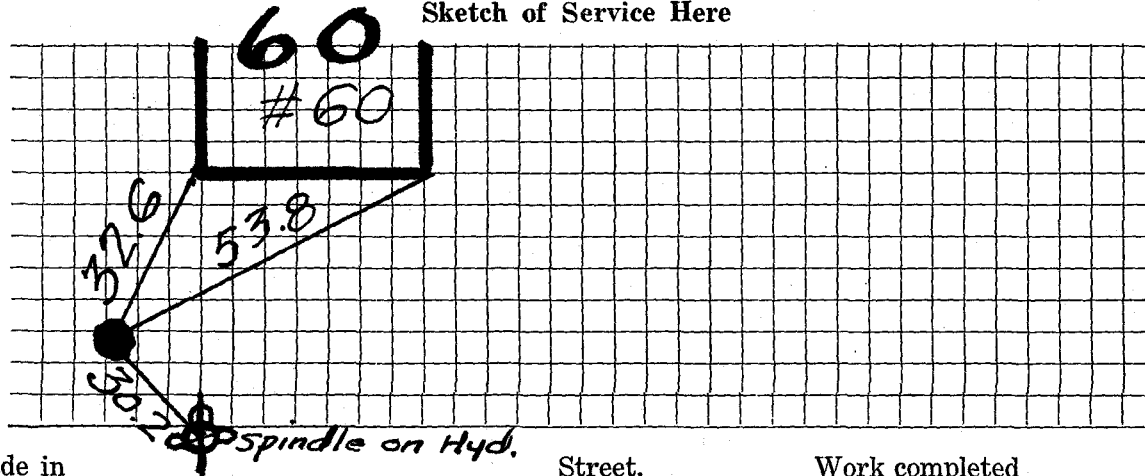

Connection made in \_\_\_\_\_ Street.

Work completed \_\_\_\_\_ 19

Remarks: