

WATER SERVICE RECORD

#5419

Name Alfred Todice

Service No. 75

Address 63 Winter Street

Location

~~Extended Service~~ - New Service

W.O. #8097

Comm 10-28-63


Date	Material	Amount	Total	Date	Amount
8-13-63	Labor	5 07		8-2-63	Deposit 100 00
	10% O.H.	51	5 58	10-28-63	Refund 53 05
	60' 3/4" Copper Tubing @ .42		25 20		46 95
	1 3/4" C x 1/2 I.W.H. Stop & Waste		6 17		NON CHARGE
	1 hr. Trucking @ 3.00		* 3 00		Labor 18 77
	7 x 3 Patch		7 00		12' 3/4" Copper Tubing @.42 5 04
			46 95		1 3/4" C.Corp. Cock 4 91
					1 3/4" C.Curb Cock 6 28
					1 Box & Rod 4 90
					1 3/4" C3 part Union 2 41
					1 hr. town shovel 6 50
					48 81

DATE _____

TOWN OF LEXINGTON — BOARD OF PUBLIC WORKS

WATER DIVISION

Sketch of Service Here

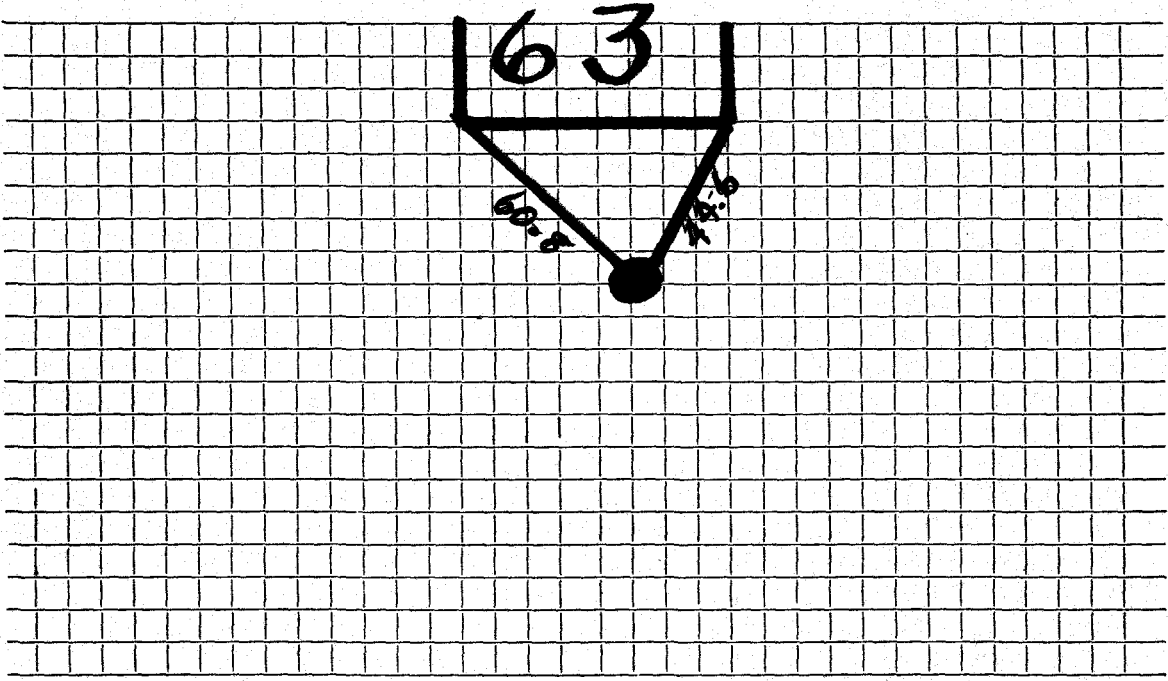

Connection made in Street. Work completed

Remarks:
.....
.....