

Name John J. Sharkey

Service No. 190
276

Address 68 Winter Street

Lexington, Mass.

Location 68 Winter Street

Kind of Pipe

Size

Size of Main

~~Repair-Renewal~~ - New Service

Com. 10-25-48

Location

Date

Material

Amount

Total

Date

Amount

Date	Material	Amount	Total	Date	Amount
Sept. 14, '48	Labor	13 83	13 83	Sept 8, 48	40 00
	10% Overhead		1 38	Mar. 17, 1952	7 39
	56' - 3/4" Copper Tubing @.255		14 28		Non-Charge
	1 - 3/4" C x 1/2" I.W.H. S & W		3 15	22' - 3/4" Copper Tubing @.255	5 61
	Trucking 1 hr. @.75		75	1 - 3/4" C Corp-cock	3 00
	Littlefield Shovel 2 hrs. @7.00		14 00	1 - 3/4" C x 3/4" C Curb-cock	3 68
			47 39	1 - Box & Rod	3 55
				2 - 1/8" Straight Tail Pieces	60
				Trucking 1 hr. @.75	75
					17 19

Labor

Bill sent 10/25/48
" " 11-29-48

DATE _____

TOWN OF LEXINGTON—BOARD OF PUBLIC WORKS

WATER DIVISION

The undersigned applies for a supply of water at No. _____ St. and hereby agrees to comply with the rules and regulations as now, or at any future time, established by the Board of Selectmen.

Am't. of Estimate \$ _____


Owner _____

Am't. Paid \$ _____

Address _____

Builder _____

Sketch of Service Here

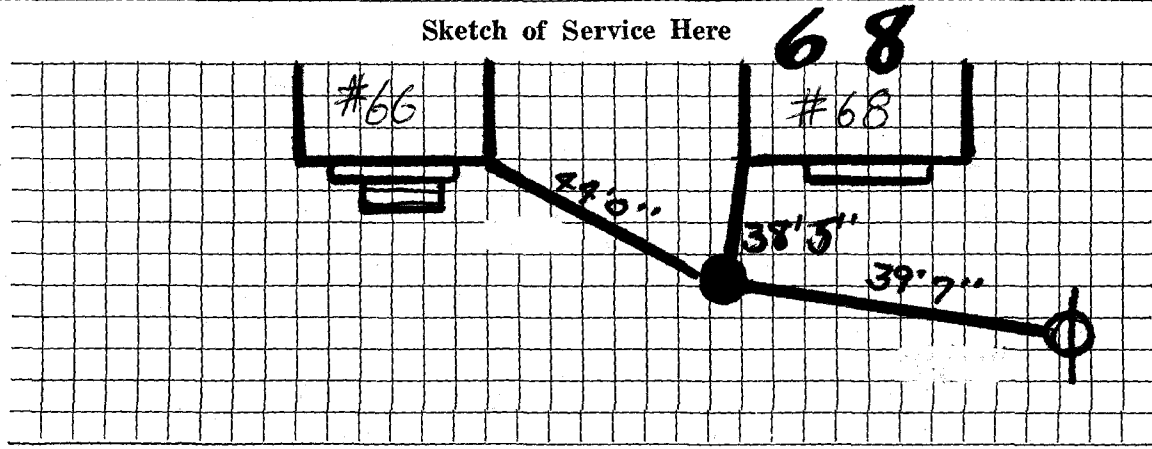

Connection made in _____ Street.

Work completed _____ 19

Remarks: