

WATER SERVICE RECORD

#413

Name Alfred Iodice

Service No. 87

Address 71 Winter Street

Location

~~Water Service~~ New Service W.O. #9089 DeFlice Bros. Permit #66


Comm 9-21-64

Date	Material	Amount	Total	Date	Amount
8-19-64	Labor	28.86		8-4-64	100.00
	10% O.H.	22.89	31.75	7-21-64	22.02
17'	3/4" Copper tubing @.42		7.14		77.96
1	3/4" C Corp Cock		4.91		
1	3/4" C Gurb Cock		6.28		
1	Box & Rod		4.90		
7 x 3	Patch		7.00		
2	hrs. Town Shovel @6.50		13.00		
1	hr. Trucking @3.00		3.00		
			77.98		
9-10-64	36' 3/4" Copper tubing				

TOWN OF LEXINGTON — BOARD OF PUBLIC WORKS

WATER DIVISION

Sketch of Service Here

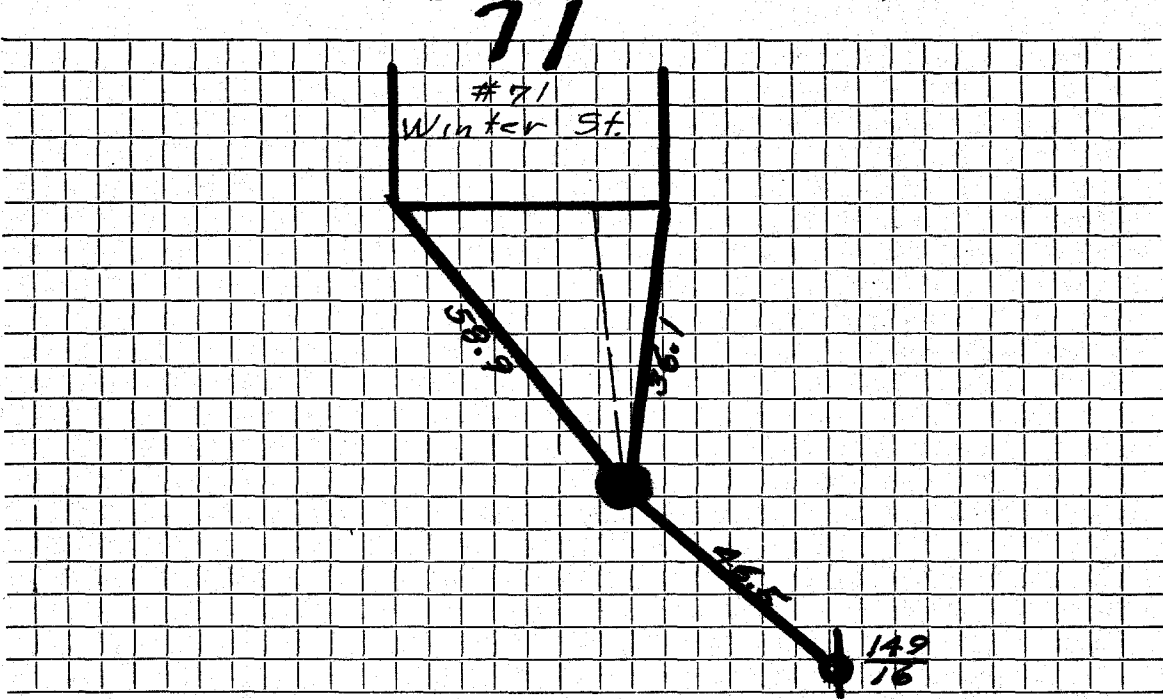

Connection made in Street. Work completed

Remarks:
.....
.....