

Name Clifford Wildes

Service No. 203

Address 74 Winter Street

# 3621

Lexington, Mass.

Location 74 Winter Street

Kind of Pipe

Size

Size of Main

~~Repair~~ ~~Renewal~~ ~~XXX~~ New Service

Com. 2-21-49

Location

Date	Material	Amount	Total	Date	Amount
Sept. 20, '48	Labor	9 19	9 19	Sept. 14 '48	30 00
	10% Overhead		92	April 25 '49	4 16
	66' - 3/4" Copper Tubing @	255 16 83			39 16
	1 - 3/4" C x 1/2" I.W.H. S&W	3 15			7 14
	1 - 3/4" C x 3/4" Union (3pts)	1 32		28' - 3/4" Copper Tubing @.255	3 00
	Shovel 1 hr. @ 7.00	7 00		1 - 3/4" C Corp-cock	3 68
	Trucking 1 hr. @.75	75		1 - 3/4" x 3/4" C Curb-cock	30
			39 16	1 - 1/2" Straight Tail Piece	30
				1 - 1/2" Offset Tail Piece	75
				Trucking 1 hr. @.75	15 17

Labor

TOWN OF LEXINGTON - BOARD OF PUBLIC WORKS

**WATER DIVISION**

The undersigned applies for a supply of water at No..... St. and hereby agrees to comply with the rules and regulations as now, or at any future time, established by the Board of Selectmen.

Am't of Estimate \$.....

Owner .....


Am't Paid \$.....

Address .....

Builder .....

Sketch of Service Here

**74**

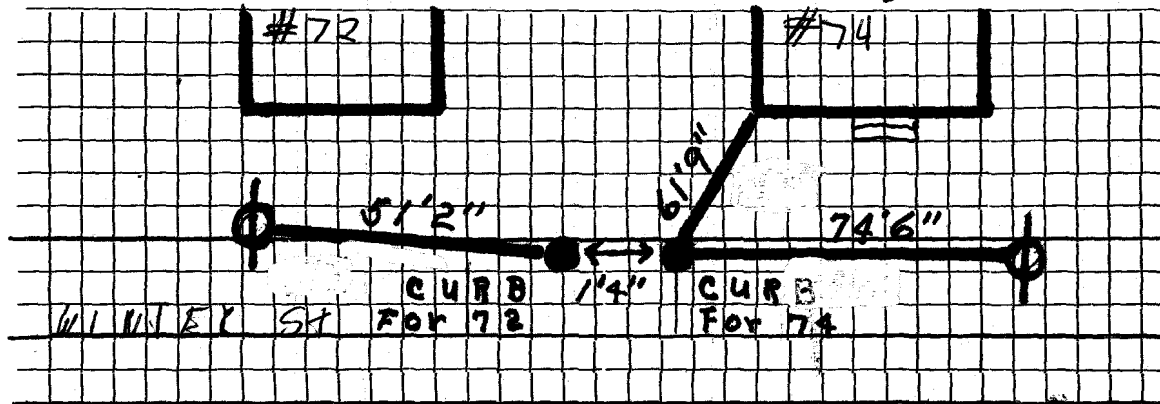

Connection made in ..... Street.

Work completed .....19

Remarks: