

Name John J. Desveaux

Service No. 147

Address 77 Winter Street

522

Location 77 Winter Street

Kind of Pipe

Size

Size of Main

~~Repair~~ ~~Removal~~ - New Service

Com. 9-19-49

Location

Date	Material	Amount	Total	Date	Amount
Aug. 3, '49	Labor	3 55	3 55	July 25 '49 Deposited	45 00
	10% Overhead		36	Sept 26 '49 Refunded	9 41
	36' - 3/4" Copper Tubing @.24	8 64		Non-Charge	35 59
	1 - 3/4" C x 1/2" I.W.H. S&W	3 29		Aug. 3, '49 Labor	3 55
	Littlefield Shovel 2 hrs. @7.00	14 00		8' - 3/4" Copper Tubing @.24	1 92
	Trucking 1 hr.		75	1 - 3/4" C Corp-cock	3 15
	Patching 5 x 3		5 00	1 - 3/4" C x 3/4" C Curb-cock	3 85
			35 59	1 - Box & Rod	3 95
				1 - 1/2" Offset Tail Piece	37
				1 - 1/2" Straight Tail Piece	37
				Littlefield Shovel 1 hr.	7 00
				Trucking 1 hr.	75
	Labor				24 91

DATE _____

TOWN OF LEXINGTON - BOARD OF PUBLIC WORKS

WATER DIVISION

The undersigned applies for a supply of water at No..... St. and hereby agrees to comply with the rules and regulations as now, or at any future time, established by the Board of Selectmen.

Am't of Estimate \$.....

Owner


Am't Paid \$.....

Address

Builder

.....

Sketch of Service Here

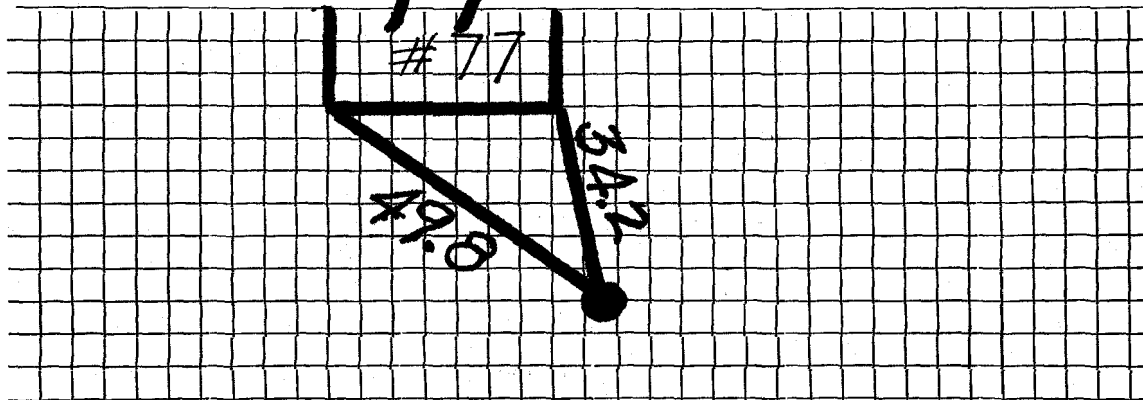

Connection made in Street.

Work completed19

Remarks: