

Name Raymond Hodgdon

Service No.

258

Address 86 Winter Street

#1562

Lexington, Mass.

Location

Kind of Pipe

Size

Size of Main

~~Repair-Replace~~ New Service

Location

| Date | Material | Amount | Total | Date | Amount |
|--------------|---------------------------------|--------|-------|--------------|------------------------------|
| Oct. 26, '48 | Labor | 1 25 | 1 25 | Oct. 26, '48 | 20 00 |
| | 35'-3/4" Copper Tubing @ .255 | 8 93 | 8 93 | Dec. 31, '48 | 4 47 |
| | 1-3/4" C x 1/2" I.W.H. S&W | 3 15 | 3 15 | | 15 03 |
| | 1-3/4" C x 3/4" C. Union (3pts) | 1 32 | 1 32 | Oct. 26, '48 | 5 65 |
| | 1 hr. Trucking | | 75 | | 28'-3/4" Copper Tubing |
| | | | 15 53 | | 1-3/4" C. Corp cock |
| | | | | | 1-3/4" C x 3/4" C. curb-cock |
| | | | | | 1-Box & Rod |
| | trench dug by owner. | | | | 1-1/2" Straight Tail Piece |
| | | | | | 1-1/2" Offset Tail Piece |
| | | | | | 2 hrs. Littlefield Shovel |
| | | | | | 1 hr. Trucking |
| | Labor | | | | 38 37 |

DATE _____

TOWN OF LEXINGTON - BOARD OF PUBLIC WORKS

WATER DIVISION

The undersigned applies for a supply of water at No..... St. and hereby agrees to comply with the rules and regulations as now, or at any future time, established by the Board of Selectmen.

Am't of Estimate \$.....

Owner


Am't Paid \$.....

Address

Builder

.....

Sketch of Service Here

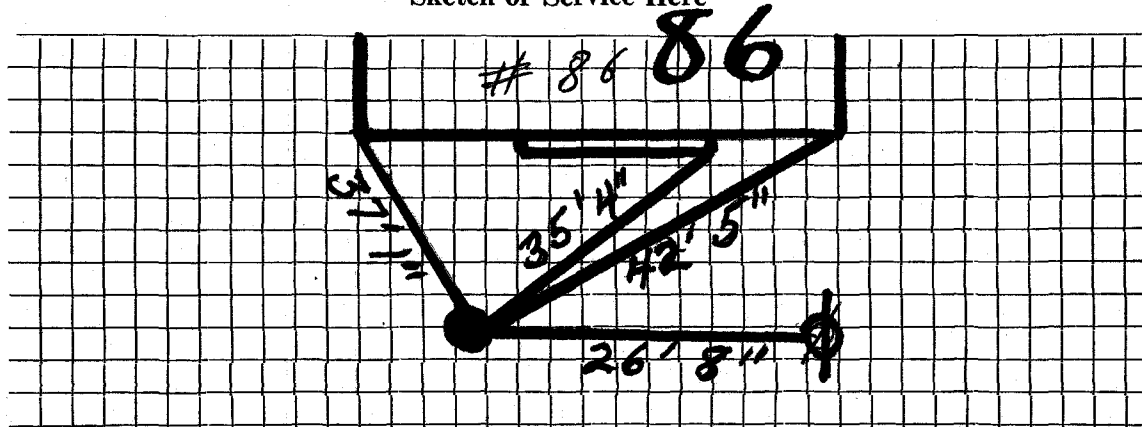

Connection made in Street.

Work completed19

Remarks: