

Name Edwin L. Carr  
 Address 88 Winter Street  
 Lexington, Mass.

Service No. 213

# 2172

Location 88 Winter Street

Kind of Pipe Size Size of Main

~~Renewal~~ ~~Renewal~~ New Service

Location

Date	Material	Amount	Total	Date	Amount
Sept. 18, '48	Labor	4 80	4 80	Sept 19 / 48	30 00
	10% Overhead		48		
	42' - 3/4" Copper Tubing @.255	10 71			
	1 - 3/4" C x 1/2" I.W.H. S & W	3 15			
	Trucking 1 hr. @.75	75			
			19 89		
				28' - 3/4" Copper Tubing @.255	7 14
				1 - 3/4" C Corp-cock	3 00
				1 - 3/4" C x 3/4" C Curb-cock	3 68
				1 - Box & Rod	3 55
				1 - 1/2" Offset Tail Piece	30
				1 - 1/2" Straight Tail Piece	30
				Trucking 1 hr. @.75	75
					18 72
	Labor				

*Departed*

Non-Charge

Trench dug by owner

*Com. 10/25/48*

trench dug by owner.

*19 29*

Hadley Press, Inc., Lexington

DATE \_\_\_\_\_

# TOWN OF LEXINGTON—BOARD OF PUBLIC WORKS

## WATER DIVISION

The undersigned applies for a supply of water at No. \_\_\_\_\_ St. and hereby agrees to comply with the rules and regulations as now, or at any future time, established by the Board of Selectmen.

Am't. of Estimate \$ \_\_\_\_\_


Owner \_\_\_\_\_

Am't. Paid \$ \_\_\_\_\_

Address \_\_\_\_\_

Builder \_\_\_\_\_

Sketch of Service Here

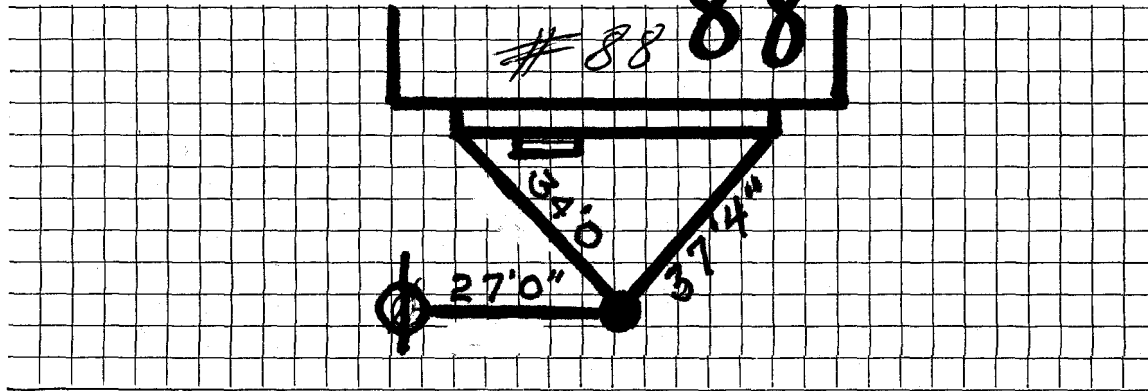

Connection made in \_\_\_\_\_ Street.

Work completed \_\_\_\_\_ 19

Remarks: