

Name Bernice Miller

Service No.

188#3345

Address 89 Winter Street

Lexington, Mass.

Location 89 Winter Street

Kind of Pipe

Size

Size of Main

~~REPAIR WORK~~ New Service

Com. 9-26-19

Location

Date	Material	Amount	Total	Date	Amount
Sept. 17, '19	Labor	4 25	4 25	Sept 19 '19	45 00
	10% Overhead		41	Oct 6 '19	4 58
	33' - 3/4" Copper Tubing @.24		7 92		No Charge
	1 - 3/4" C x 1/2" I.W.H. S&W		3 29	Sept. 17, '19	Labor
	Littlefield Shovel 3 hrs @7.00	21 00	21 00	10' - 3/4" Copper Tubing @.24	2 40
	Trucking 1 hr. @.75		75	1 - 3/4" C Corp-cock	3 15
	Patching 3 x 3		3 00	1 - 3/4" C x 3/4" C Curb-cock	3 85
			40 42	1 - Box & Rod	3 75
				1 - 1/2" Offset Tail Piece	37
				1 - 1/2" Straight Tail Piece	37
				Littlefield Shovel 1 1/2 hrs. @7.00	10 50
				Trucking 1 hr. @.75	75
	Labor				29 19

DATE \_\_\_\_\_

TOWN OF LEXINGTON – BOARD OF PUBLIC WORKS  
**WATER DIVISION**

The undersigned applies for a supply of water at No..... St. and hereby agrees to comply with the rules and regulations as now, or at any future time, established by the Board of Selectmen.

Am't of Estimate \$.....

Owner .....


Am't Paid \$.....

Address .....

Builder .....

.....

Sketch of Service Here

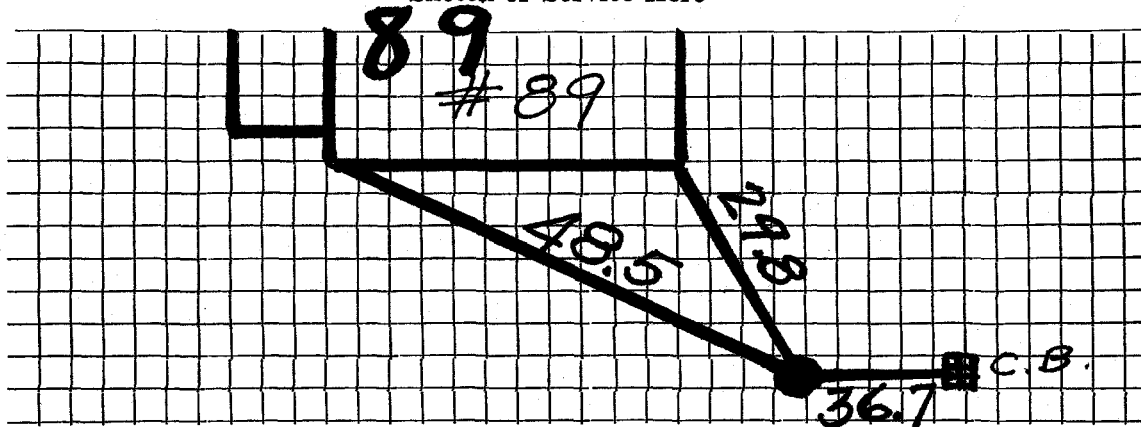

Connection made in ..... Street.

Work completed .....19

Remarks: