

Name James Casey
 Address 94 Winter Street
 Lexington, Mass.

Service No. 212
 #6982

Location 94 Winter Street

Kind of Pipe

Size

Size of Main

~~REPAIR-RENEW~~ New Service

Location

Date	Material	Amount	Total	Date	Location	Amount
Sept. 2, '48	Labor	1 25	1 25	Sept 16 '48	Deported	35 00
	10% Overhead		13	Oct 22 '48	Refunded	13 10
	60' - 3/4" Copper Tubing @.255	15 30	15 30		Non-Charge	21 90
	15' - 3/4" Copper Tubing (no charge)			Sept. 21, '48	Labor	2 35
	1 - 3/4" C x 1/2" I.W.H. S & W	3 15	3 15	29' - 3/4" Copper Tubing @.255		7 40
	1 - 3/4" C x 3/4" C Union (3pts)	1 32	1 32	1 - 3/4" C Corp-cock		3 00
	Trucking 1 hr. @.75		75	1 - 3/4" C x 3/4" C Curb-cock		3 68
			21 90	1 - Box & Rod		3 55
				1 - 1/2" Offset Tail Piece		30
				1 - 1/2" Straight Tail Piece		30
				Littlefield Shovel 2 hrs. @7.00		14 00
				Trucking 1 hr. @.75		75
	Labor					35 33

Com. 10/25/48

trench dug by owner.

DATE _____

TOWN OF LEXINGTON—BOARD OF PUBLIC WORKS

WATER DIVISION

The undersigned applies for a supply of water at No. _____ St. and hereby agrees to comply with the rules and regulations as now, or at any future time, established by the Board of Selectmen.

Am't. of Estimate \$ _____


Owner _____

Am't. Paid \$ _____

Address _____

Builder _____

Sketch of Service Here

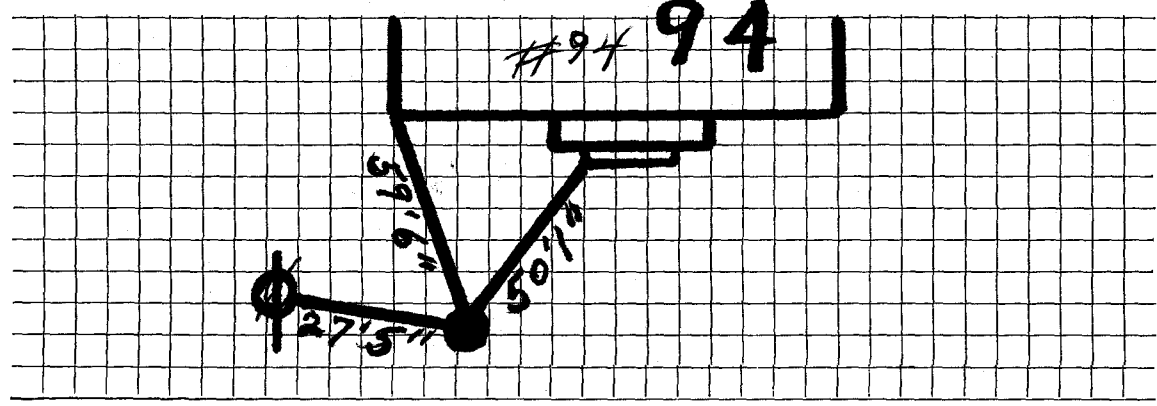

Connection made in _____ Street.

Work completed _____ 19

Remarks: