

WATER SERVICE RECORD

Name Philip C. Heidke Realty Trust

Service No. 47

Address 95 Winter Street

Location

~~Repair~~ ~~Renewal~~ New Service W.O.#5696 Eagle #3303

FEB 13 1978

Date	Material	Amount	Total	Date	Amount
2/1/78	Labor	112.44		2-6-78	140.00
	10% O.H.	11.24	123.68	2-24-78	47.12
8'	3/4" Copper tubing @.83		6.64		187.12
1	3/4" Corp		11.27		
1	3/4" Curb		16.12		
1	Box & Rod		13.41		
1	hr. Trucking @ 3.00		3.00		
2	hrs. Town Shovel @6.50		13.00		
			187.12		


Deposit Paid

DATE _____

TOWN OF LEXINGTON — BOARD OF PUBLIC WORKS

WATER DIVISION

Sketch of Service Here

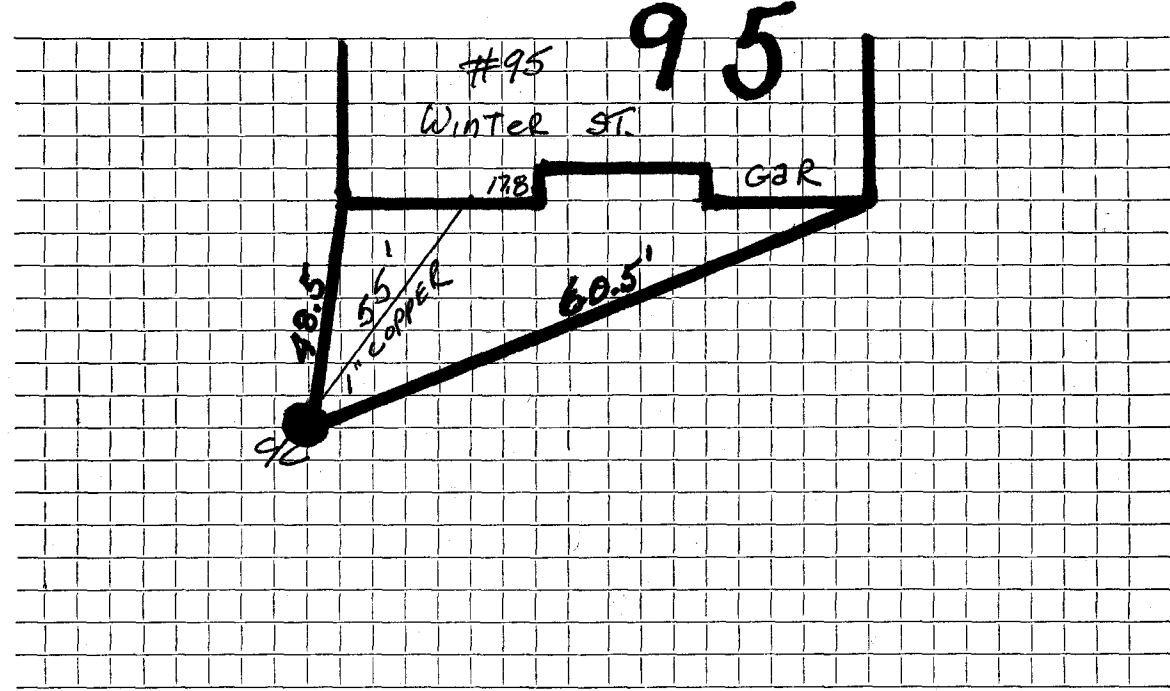

Connection made in Street. Work completed

Remarks:
.....
.....