

Name Owen MacDonald  
 Address 96 Winter Street  
 Lexington, Mass.

#4409  
 Service No. 200

Location 96 Winter Street

Kind of Pipe Size Size of Main

~~Repair - Renewal~~ - New Service

Location

Date	Material	Amount	Total	Date	Location	Amount
Sept. 14, '48	Labor	2 25	2 25	Sept 13. 48	Departed	30 00
	10% Overhead		23			
	50' - 3/4" Copper Tubing		12 75		Non-Charge	20 45
	1-3/4" C x 1/2" I.W.H. S & W		3 15	Sept. 14, '48	Labor	6 69
	1-3/4" 8 x 3/4" C. Union (3 pts.)		1 32		35' - 3/4" Copper Tubing	893
	1 hr. Trucking		75		1-3/4" C x 3/4" C. Curb Cock	3 68
			20 45		1-Box & Rod	3 55
					1-1/2" Straight Tail Piece	30
					1-1/2" Offset Tail Piece	30
					1 hr. Trucking	75
						27 20
	Com. 10/25/48					
	trench dug by owner.					
	Labor					

Hadley Press, Inc., Lexington

# TOWN OF LEXINGTON—BOARD OF PUBLIC WORKS

## WATER DIVISION

The undersigned applies for a supply of water at No. \_\_\_\_\_ St. and hereby agrees to comply with the rules and regulations as now, or at any future time, established by the Board of Selectmen.

Am't. of Estimate \$ \_\_\_\_\_


Owner \_\_\_\_\_

Am't. Paid \$ \_\_\_\_\_

Address \_\_\_\_\_

Builder \_\_\_\_\_

Sketch of Service Here

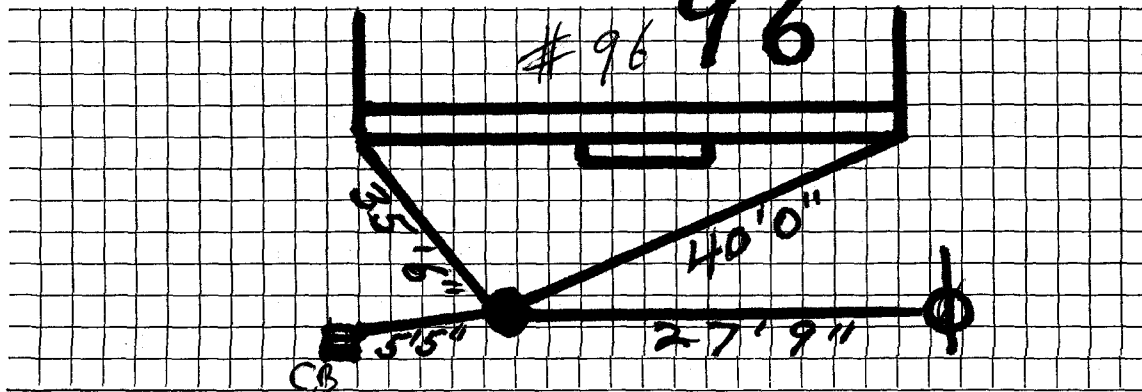

Connection made in \_\_\_\_\_ Street.

Work completed \_\_\_\_\_ 19

Remarks: