

Name William A. Driscoll

Service No. 25 2968

Address 25 Winthrop Road

Lexington, Mass.

Location 25 Winthrop Road

Kind of Pipe

Size

Size of Main

Repair—Renewal—New Service

Location

Date	Material	Amount	Total	Date	Amount
Dec. 9, '44	Labor	30 70			
	10% Overhead	3 07	33 77		
	45' 1" Copper Tubing		10 53		
	Trucking 1 hr. @.75		75		
			<u>45.05</u>		
				<i>No Deposit</i>	
				Non-Charge	
				10' - 1" Copper Tubing	
				1 - 1" C. Corp-cock	
				1 - 1" C x 1" C Curb-cock	
				2 - 1" Tail Pieces	
				1 - Box & Rod	
				Trucking 1 hr.	
				Patching	
	Labor				

Hadley Press, Inc., Lexington

# TOWN OF LEXINGTON—BOARD OF PUBLIC WORKS

## WATER DIVISION

The undersigned applies for a supply of water at No. \_\_\_\_\_ St. and hereby agrees to comply with the rules and regulations as now, or at any future time, established by the Board of Selectmen.

Am't. of Estimate \$ \_\_\_\_\_


Owner \_\_\_\_\_

Am't. Paid \$ \_\_\_\_\_

Address \_\_\_\_\_

Builder \_\_\_\_\_

Sketch of Service Here

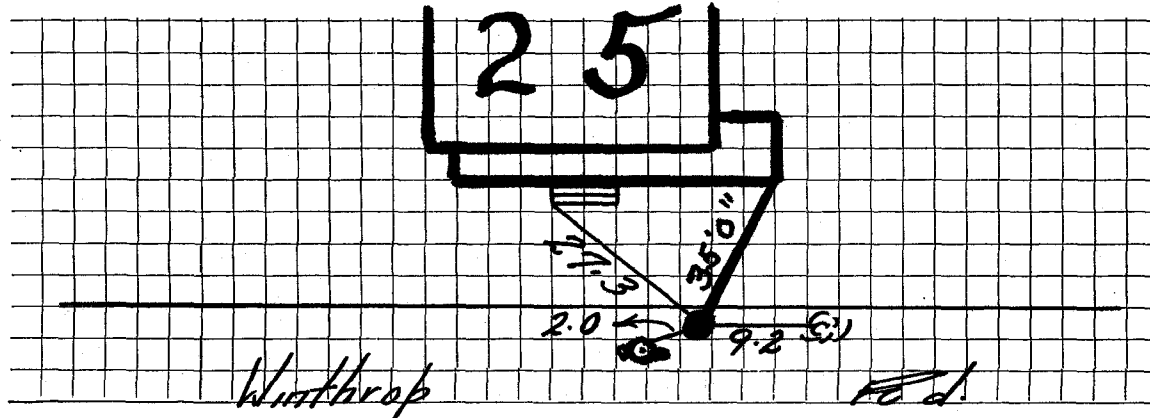

Connection made in \_\_\_\_\_ Street.

Work completed \_\_\_\_\_ 19

Remarks: