




TOWN OF LEXINGTON — BOARD OF PUBLIC WORKS

WATER DIVISION

Sketch of Service Here

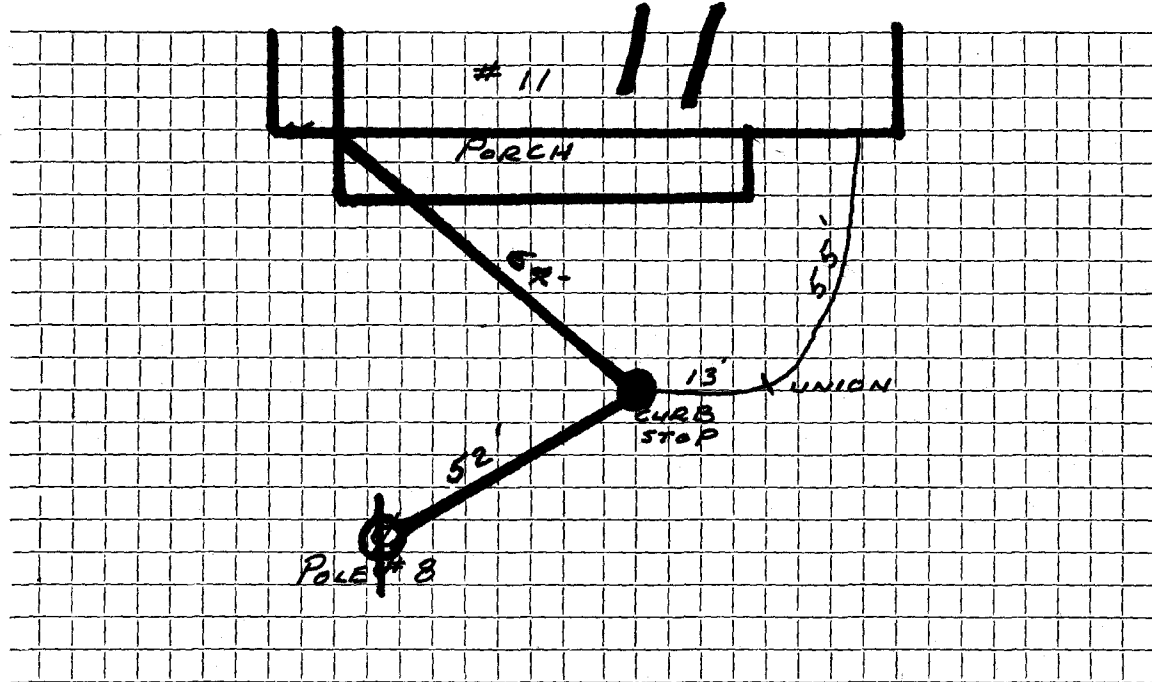

Connection made in WINTHROP Street. Work completed .....

Remarks: .....  
.....  
.....




DATE 10-27-2006

TOWN OF LEXINGTON — BOARD OF PUBLIC WORKS

WATER DIVISION

Sketch of Service Here

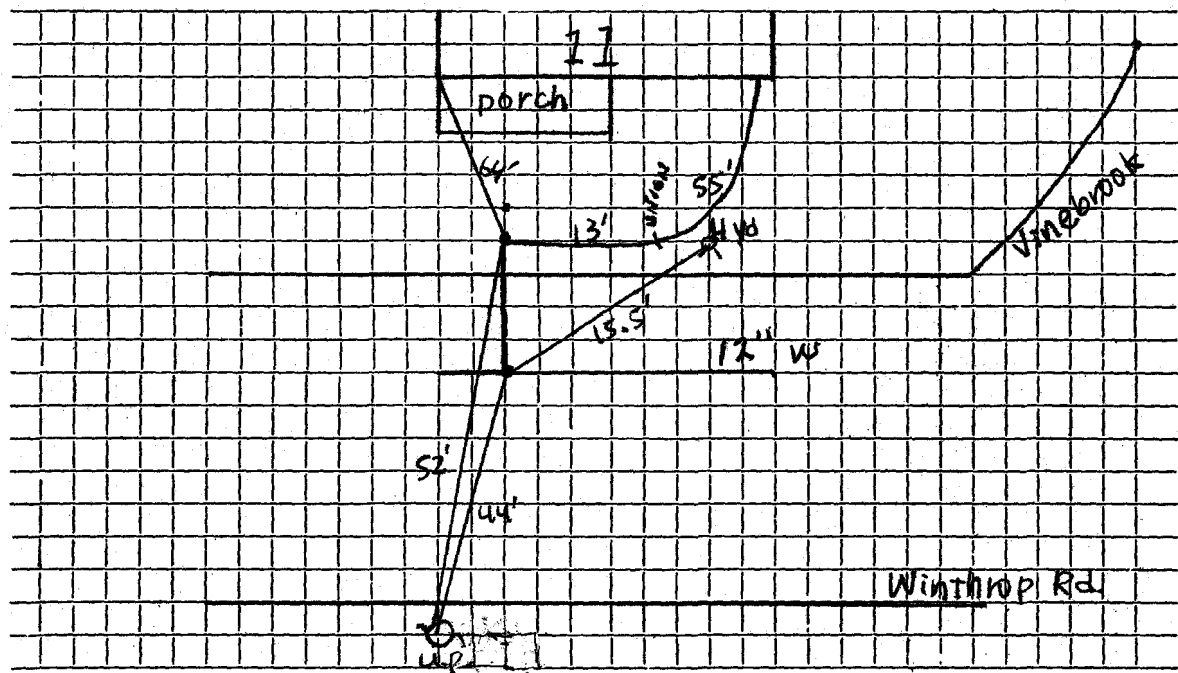

Connection made in Winthrop Rd. (Adjacent side) Street.

Work completed Granese & Sons, Inc. (Sub Defelice)

Remarks: .....

Contract field book # 1 D. 2000