


DATE 11-2-00

TOWN OF LEXINGTON — BOARD OF PUBLIC WORKS

WATER DIVISION

Sketch of Service Here

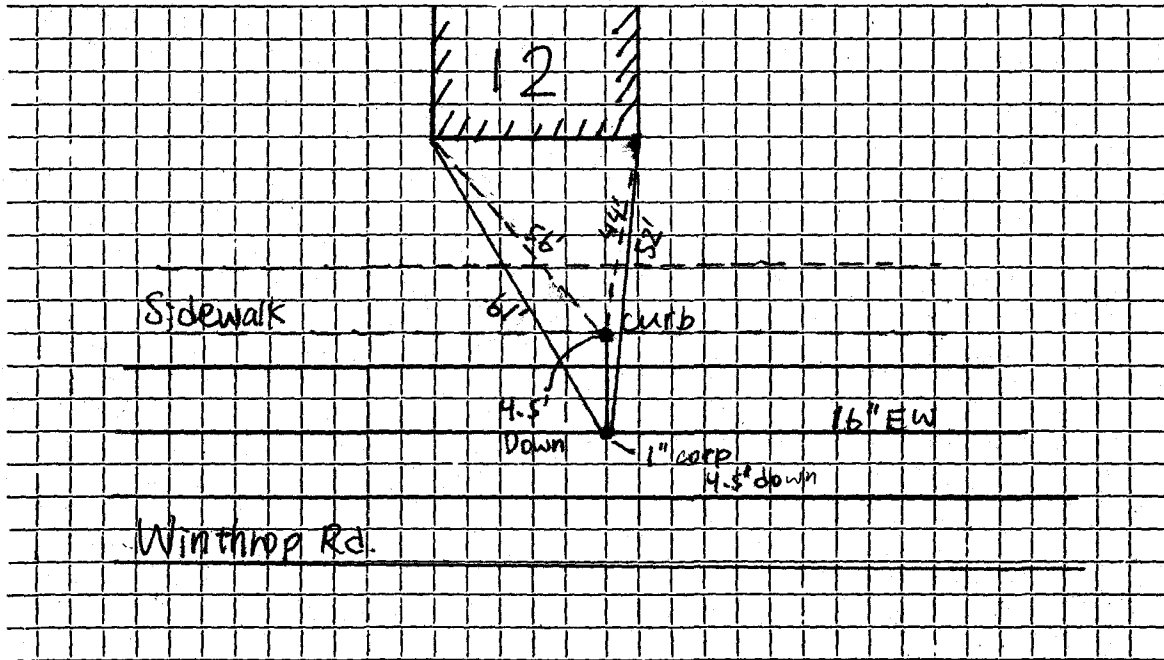

Connection made in Street. Work completed *Granese & Sons, Inc.*

Remarks:
.....
.....

WATER SERVICE RECORD

Name Horace MacKecknie

Service No. 31

Address 12 Winthrop Road

3169

Location Lexington

~~Renewal~~ - ~~New Service~~ COM. 4-28-52


Date	Material	Amount	Total	Date	Amount
4/2/52	Labor	17 73	17 73	3-15-52	Deposited 75 00
	10% overhead		1 77	4-28-52	Refund 9 61
	47' - 1" copper tubing@.4048		19 02		<u>NON CHARGE</u> 65 89
	1 - 1" C x 3/4" I.W.H.stop& waste		5 12	4/3/52	Labor 32 93
	3 hrs. Littlefield shovel@ 7.		21 00		27' - 1" copper tubing@.4048 10 92
	1 hr. trucking		75		1 - 1" C. corp-cock 5 61
			65 39		1 - 1" C x 1" C. curb-cock 6 80
					1 - box and rod 4 52
					2 - 3/4" straight tail piece 50
					4 hrs. Littlefield shovel 28 00
					1 hr. trucking 75
					patching 24 x 3 24 00
					<u>114 03</u>

DATE _____

TOWN OF LEXINGTON — BOARD OF PUBLIC WORKS

WATER DIVISION

Sketch of Service Here

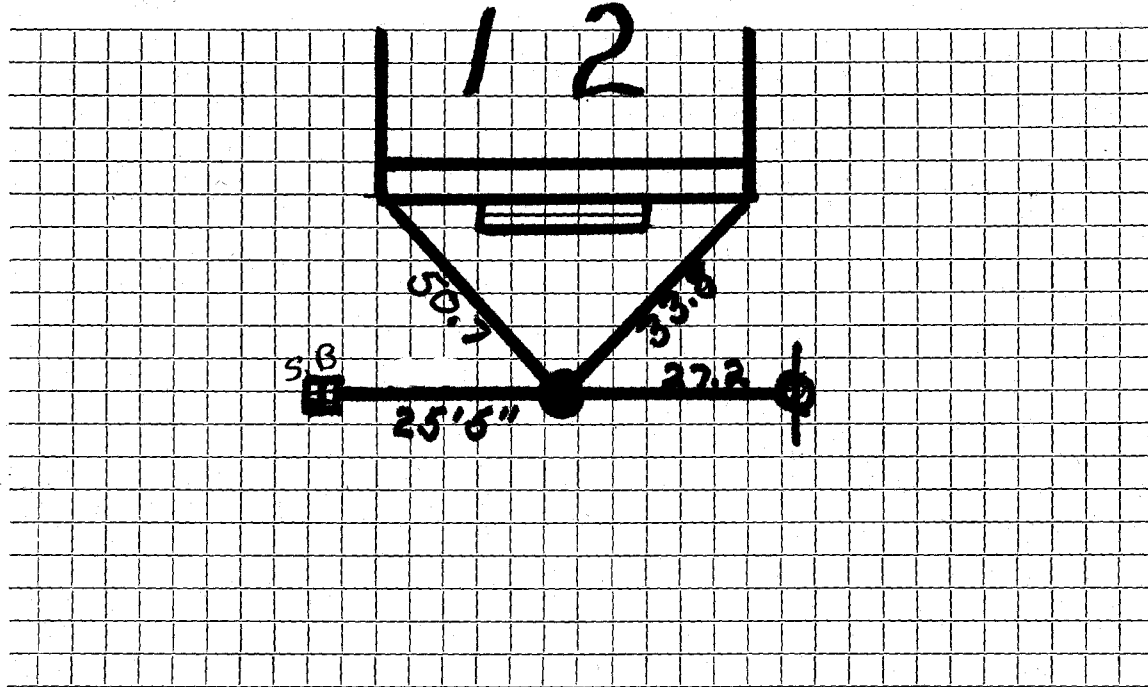

Connection made in Street. Work completed

Remarks:

.....

.....