

WATER SERVICE RECORD

Name Charles DeVoe

Service No. 264

Address 14 Winthrop Road

#7306

Location

~~Repair-Renewal-New Service~~ COM.10-10-55


Date	Material	Amount	Total	Date	Amount
Aug.23/55	Labor	12 80		8-16-55 Deposited	25 00
	10% overhead	1 28		10-10-55 Refunded	4 33
			14 08	<u>NON CHARGE</u>	20 67
	52'-1" copper tubing @.4584		23 84	Aug.23/55 Labor	7 40
	1-1"C x 3/4" IWH stop & waste		4 50	18'-1" copper tubing @.4584	8 25
	15 x 3 patching		15 00	1-1"C corp cock	5 61
	1 hr. trucking @.75		75	1-1" C x 1"C curb cock	6 80
	3 hrs. Littlefield Shovel @7.50		22 50	1 Box and Rod	3 90
			80 67	1-1/2" offset tail piece	50
				1-1/2" straight tail piece	50
				1 hr. trucking @.75	75
				1 hr. Littlefield Shovel @ 7.50	7 50
					41 21
				4/5/65 LEAK IN CURB	

DATE _____

TOWN OF LEXINGTON — BOARD OF PUBLIC WORKS

WATER DIVISION

Sketch of Service Here

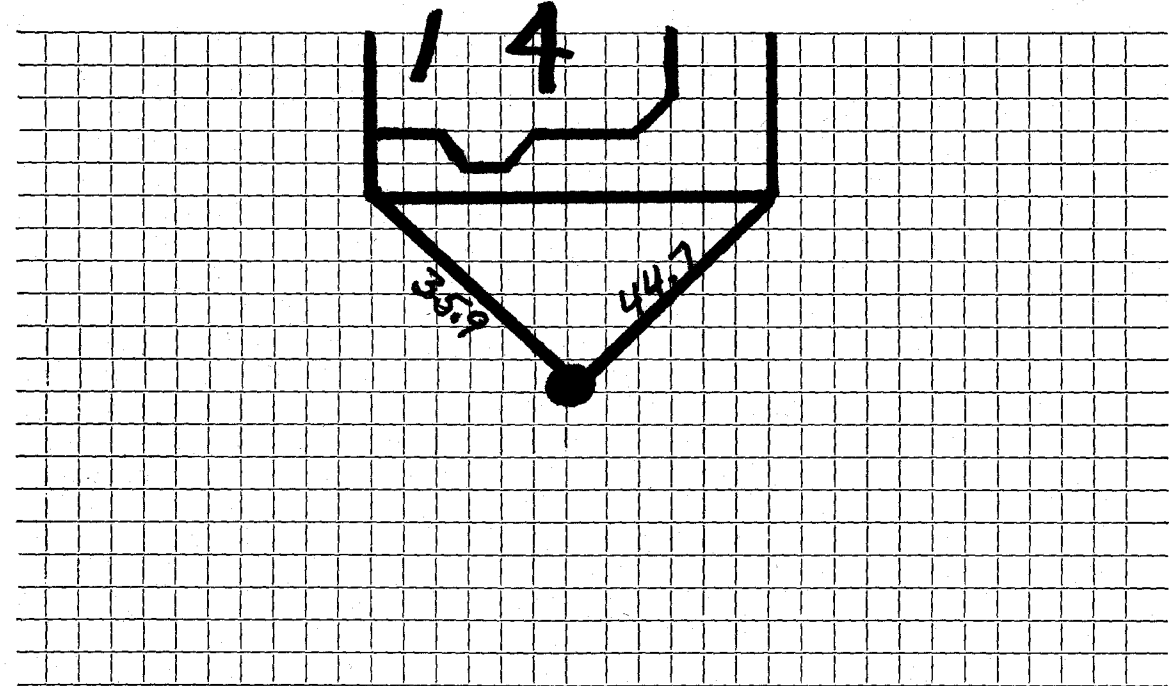

Connection made in Street. Work completed

Remarks:
.....
.....