

WATER SERVICE RECORD

Name

Service No.

Address 15 Winthrop RD

Location

Repair—Renewal—New Service


Date		Material	Amount	Total	Date		Material	Amount
11/7/38	83'	3/4 COPPER			11/6/00	15'	1" COPPER	
	1	3/4 UNION 3 PART					1" COP 12" W	
	1	3/4 S+W					1" CURB	
							BOX	
							1 1" X 3/4 UNION	

DATE 11/6/00

TOWN OF LEXINGTON — BOARD OF PUBLIC WORKS

WATER DIVISION

Sketch of Service Here

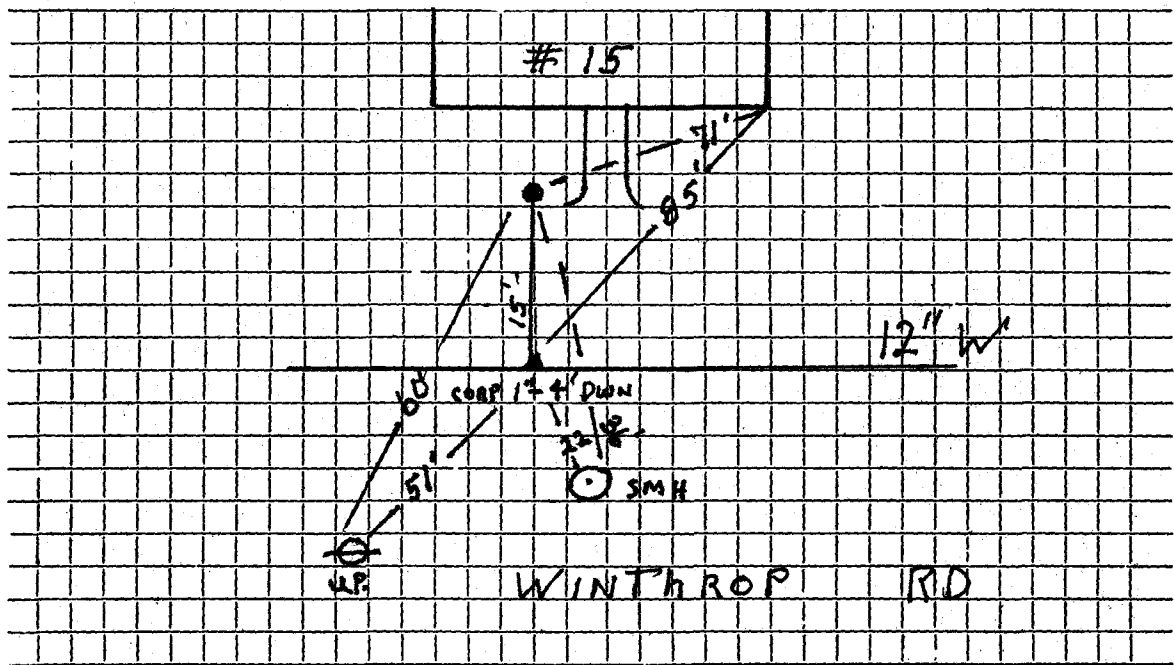

Connection made in Street. Work completed 11/6/00

Remarks:
.....
.....

Name Mrs. M.C.D.Maddison

Service No. ~~84~~ 2962

Address 15 Winthrop Road

Location

Kind of Pipe

Size

Size of Main

~~Repair & Renewal~~ - New Service

Location

Date	Material	Amount	Total	Date	Amount
1938					
11-7-38	40 1/2 hrs. @ 50¢	20 25		Nov 4, 1938	Deposited 146 00
<i>from 11-21-38</i>	76 " @ 55¢	41 80		Nov. 25, 1938	refunded 6 46
	21 " 60¢	12 60			
	17 " 70¢	<u>11 90</u>	86 55		<u>133 54</u>
	10% Overhead		8 66		
	83' 3/4" C. Tubing @ 20¢		16 60		
	1 3/4" C.xI S.& W.		3 75		
	1 3/4" C. Union (3 part)		1 10		
	4 hrs. trucking @ 75¢		3 00		
	2 hrs. compressor @ 3.00		6 00		
	Trench Repairs		<u>7 88</u>		
			\$133 54		
	Labor				

Hidley Press, Inc., Lexington

DATE _____

TOWN OF LEXINGTON—BOARD OF PUBLIC WORKS

WATER DIVISION

The undersigned applies for a supply of water at No. _____ St. and hereby agrees to comply with the rules and regulations as now, or at any future time, established by the Board of Selectmen.

Am't. of Estimate \$ _____


Owner _____

Am't. Paid \$ _____

Address _____

Builder _____

Sketch of Service Here

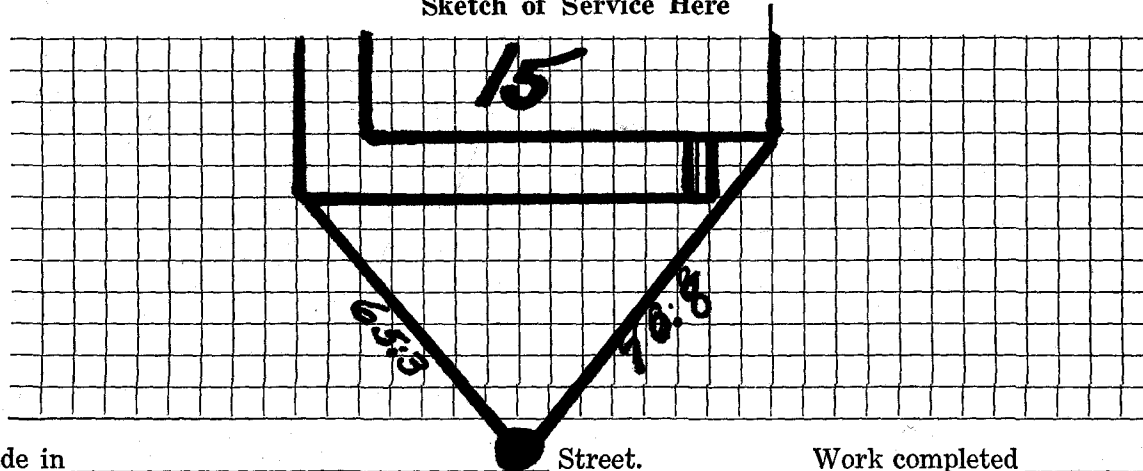

Connection made in _____ Street.

Work completed _____ 19

Remarks: