

WATER SERVICE RECORD

Name

Service No.

Address 16 Winthrop Road

Location


Repair—Renewal—~~New Service~~ W.O. #541

Date	Material	Amount	Total	Date	Amount
	CURB TO MAIN				
6-18-65	Labor	77 93			
	10% O.H.	7 79	85 72		
27'	3/4" copper tubing @ .42		17 34		
1	3/4 Adapter		2 76		
1	3/4 Curb		8 76		
1	3/4 Coupling		3 01		
1	1" Clamp		2 26		
	26 x 3 Patch		26 00		
2	Hrs. Town Truck @ 3.00		6 00		
4	Hrs. Tractor @ 6.50		26 00		
			<u>177 85</u>		

DATE _____

TOWN OF LEXINGTON — BOARD OF PUBLIC WORKS
WATER DIVISION

Sketch of Service Here

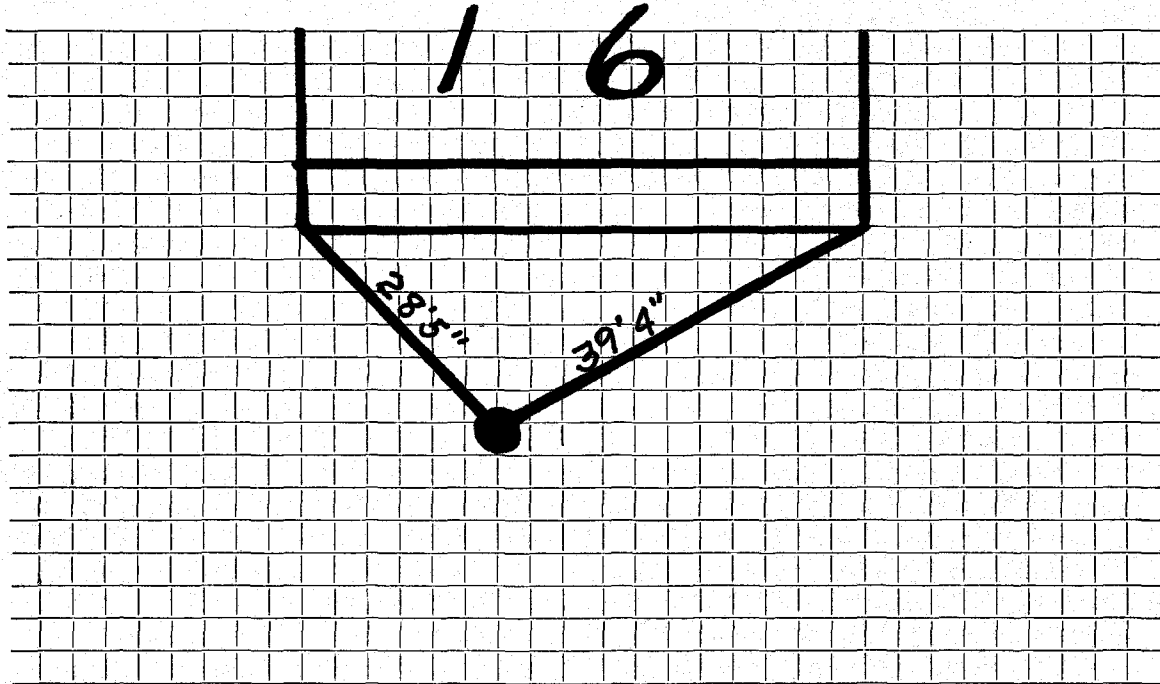

Connection made in Street. Work completed

Remarks: *Original Service... 8-2-26*

.....
.....