

WATER SERVICE RECORD

7157

Name Stanley C. Cruwys

Service No. 247

Address 18 Winthrop Road ROAD

Location

Repair—Renewal—New Service


Conn 11-28-60

Date	Material	Amount	Total	Date	Amount
10-26-60	Labor	29.34		10-26-60	Deposit 100.00
	10% O. H.	2.93	32.27	11-28-60	Returned 26.52
37'	3/4" Copper tubing @.42		15.54		73.78
1	3/4" C x 1/2 I.W.H. Stop & Waste		6.17		Curb to Main
2	hrs. Trucking @3.00		6.00	10-26-60	Labor 34.92
3	hrs. Pippin Shovel @4.50		13.50	44'	3/4" Copper tubing @.42 18.48
			73.48	1	3/4" C Corp Cock 4.91
				1	3/4" C Curb Cock 6.28
				1	Box & Rod 4.90
				1	1/2 Straight tail piece .50
				1	1/2 Offset tail piece .50
				1	hr. Trucking @3.00 3.00
				2	hrs. Pippin Shovel @4.50 9.00
				4	0 x 3 Patch 40.00
					122.49

DATE _____

TOWN OF LEXINGTON — BOARD OF PUBLIC WORKS
WATER DIVISION

Sketch of Service Here

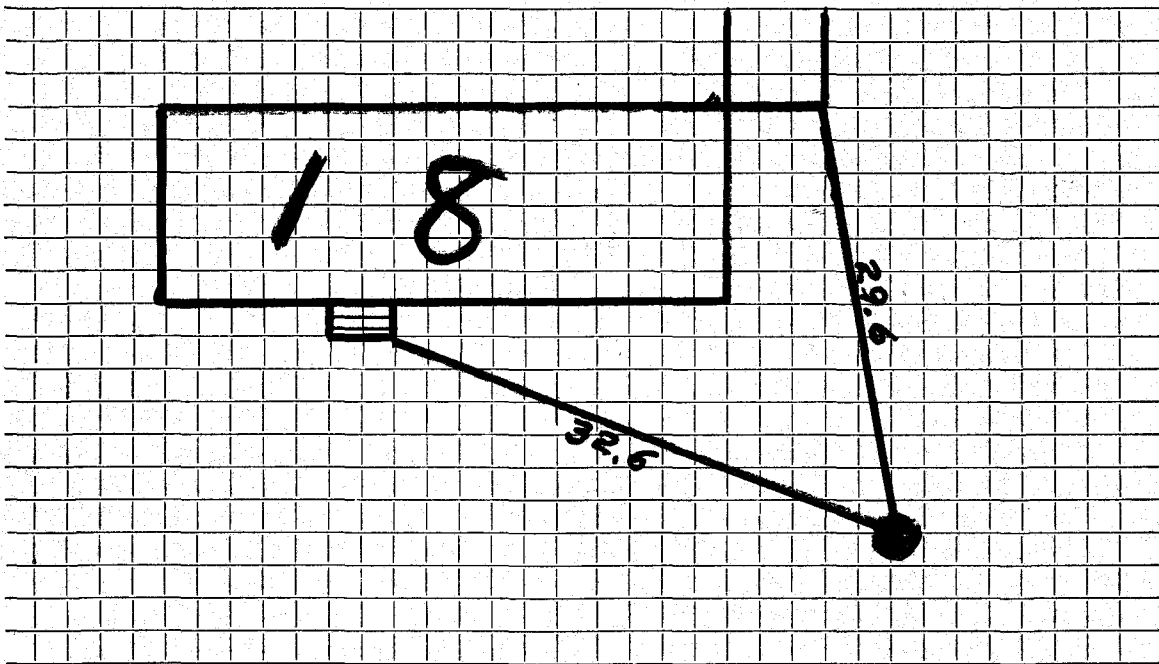

Connection made in Street. Work completed

Remarks:
.....
.....