

Name Harold B. Lamont

Service No. ~~36~~ 2966

Address 20 Winthrop Road

## Location

Kind of Pipe

Size

Size of Main

~~Repair - Renewal - New Service~~

Location

Date	Material	Amount	Total	Date	Location	Amount
11-27-45	Labor	10 98		Nov. 28 '45	Deposited	60 00
	"	28 42	39 40	Dec. 27 '45	Cash	72
	10% Overhead		3 94		Non-Charge	60 72
	60' - 1" Copper Tubing		14 04	11-28-45	Labor	7 65
	1 - 1" C x $\frac{3}{4}$ " I.W.H. Stop & Wst.	2 59		9 - 1" Copper Tubing		2 11
	Trucking 1 hr.		75	1 - 1" C x 1" C Curb-cock		3 53
			60 72	1 - 1" Copper Adapter		1 70
				1 - 1" Offset Tail Piece		38
				Trucking 1 hr.		75
				Patching 5 x 3		3 32
						19 44
	Labor					

DATE \_\_\_\_\_

# TOWN OF LEXINGTON—BOARD OF PUBLIC WORKS

## WATER DIVISION

The undersigned applies for a supply of water at No. \_\_\_\_\_ St. and hereby agrees to comply with the rules and regulations as now, or at any future time, established by the Board of Selectmen.

Am't. of Estimate \$ \_\_\_\_\_


Owner \_\_\_\_\_

Am't. Paid \$ \_\_\_\_\_

Address \_\_\_\_\_

Builder \_\_\_\_\_

Sketch of Service Here

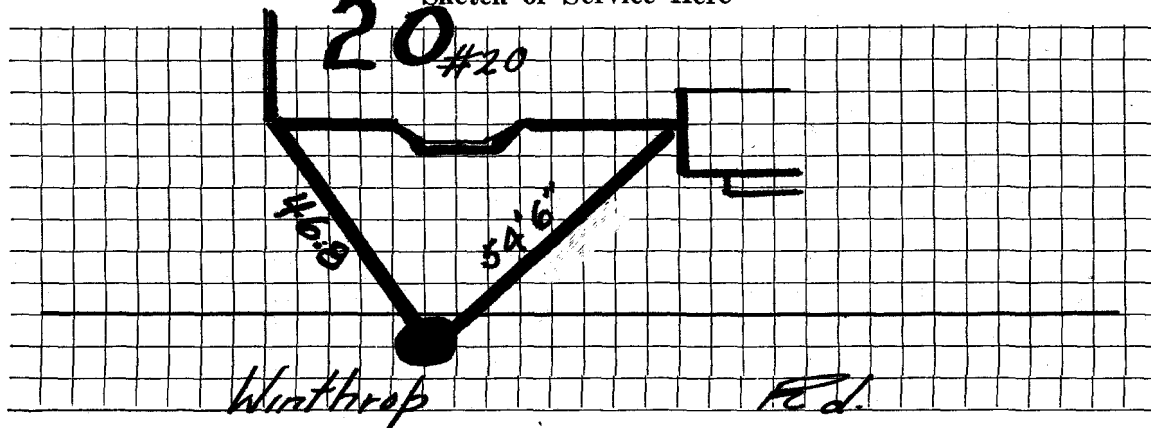

*Wentrop*

*R.D.*

Connection made in \_\_\_\_\_ Street.

Work completed \_\_\_\_\_ 19

Remarks: