

WATER SERVICE RECORD

Name **Foley Const.**

Service No. **4**

Address **37 Winthrop Road**

Location **Lot #53 Sta 1+60 Right (VACANT LOT)**

~~Repair - Repair~~ **New Service** Deflice Bros. Permit #A175

MAY 2 1966

| Date | Material | Amount | Total | Date | Amount |
|---------|----------------------------|--------|-------|---------|----------------------------------|
| 7-18-62 | Labor | 2.41 | | 3-11-66 | 28 50 |
| | 10% O.H. | .24 | 2.65 | | |
| | 9' 3/4" Copper tubing @.42 | | 3.78 | | |
| | BILL WHEN CONNECTED | | 6.43 | | |
| | | | 22 07 | | NON CHARGE |
| 3-8-66 | 52' 3/4" Copper tubing | | 28 50 | 7-18-62 | Labor 1.78 |
| | | | | | 10' 3/4" Copper tubing @.42 4.20 |
| | | | | | 1 3/4" C Corp Cock 4.91 |
| | | | | | 1 3/4" C Curb Cock 6.28 |
| | | | | | 1 Box & Rod 4.90 |
| | | | | | 22.07 |


DATE _____

TOWN OF LEXINGTON — BOARD OF PUBLIC WORKS

WATER DIVISION

TIE TO DRESSER Coupling

Sketch of Service Here

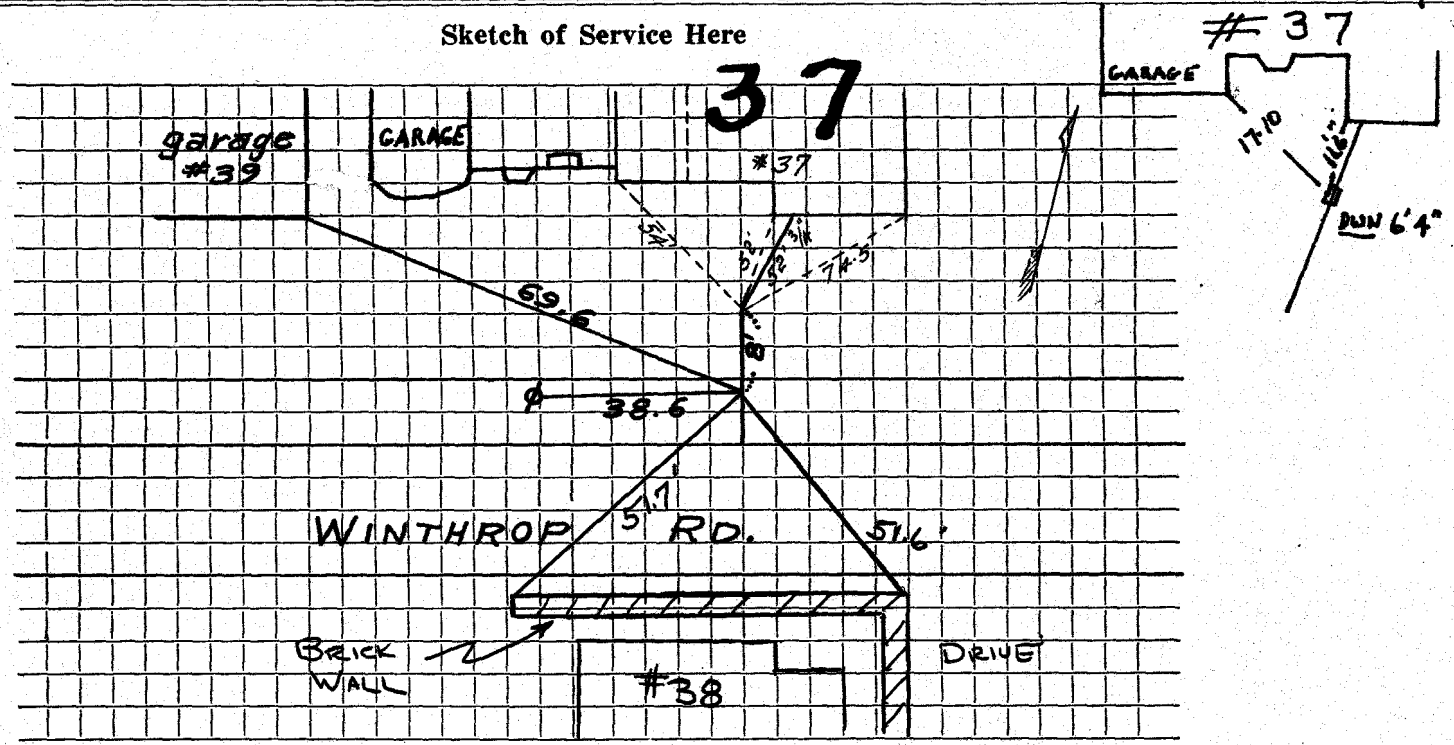

Connection made in Street. Work completed

Remarks: DRESSER Coupling HAS RUBBER SLEEVE TO STOP ELEC. CURRENT.

.....
.....