

WATER SERVICE RECORD

#276

Name Nicholas Bouras

Service No. 200

Address 39 Winthrop Road

Location

~~Repair~~ - New Service

Com. 8-31-53


Date	Material	Amount	Total	Date	Amount
7/30/53	Labor	6 75		7-21-53 Deposited	60 00
	10% overhead	68	7 43	8-31-53 Refunded	15 76
	47' - 3/4" copper tubing @ .3629	17 06			<u>NON CHARGE</u>
	1 - 3/4" C x 1/2" I.W.H. stop & waste	4 00		7/30/53 Labor	8 75
	2 hrs. Littlefield shovel @ 7.50	15 00		1 - 1/2" - 3/4" copper tubing @ .3629	4 35
	1 hr. trucking		75	1 - 3/4" C. corp-cock	4 33
			44 24	1 - 3/4" C curb-cock	4 67
				1 box and rod	3 90
				1 - 1/2" offset tail pc.	50
				1 - 1/2" straight tail pc.	50
				1 hr. Littlefield shovel	7 50
				1 hr. trucking	75
					<u>35 25</u>

DATE _____

TOWN OF LEXINGTON — BOARD OF PUBLIC WORKS

WATER DIVISION

Sketch of Service Here

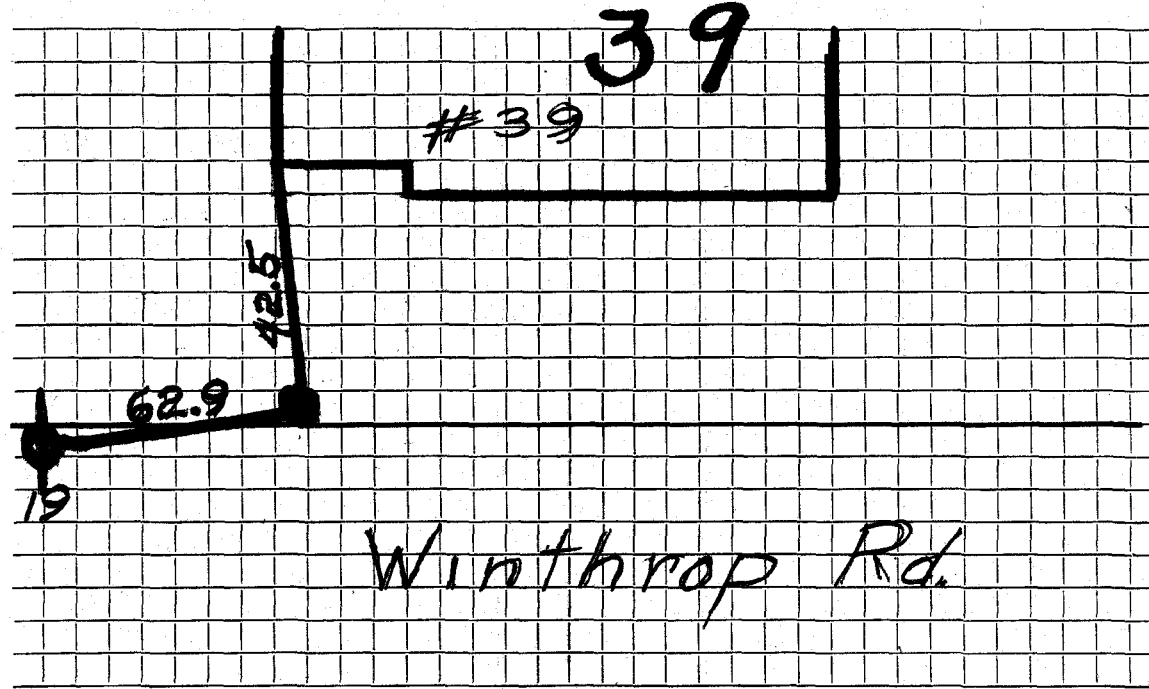

Connection made in Street. Work completed

Remarks:
.....
.....