

WATER SERVICE RECORD

Name

Service No.

Address

40 Winthrop Rd.


Location

Repair Renewal New Service

Date		Material	Amount	Total	Date		Material	Amount
		Outside					Inside	
2 1/2 boxes					10-26-98		52' - 1" copper	
7/11/50	33'	3/4 copper					1 3/4 x 1" union	
	1	3/4 curb						
	1	3/4 corp						

DATE _____

TOWN OF LEXINGTON — BOARD OF PUBLIC WORKS
WATER DIVISION

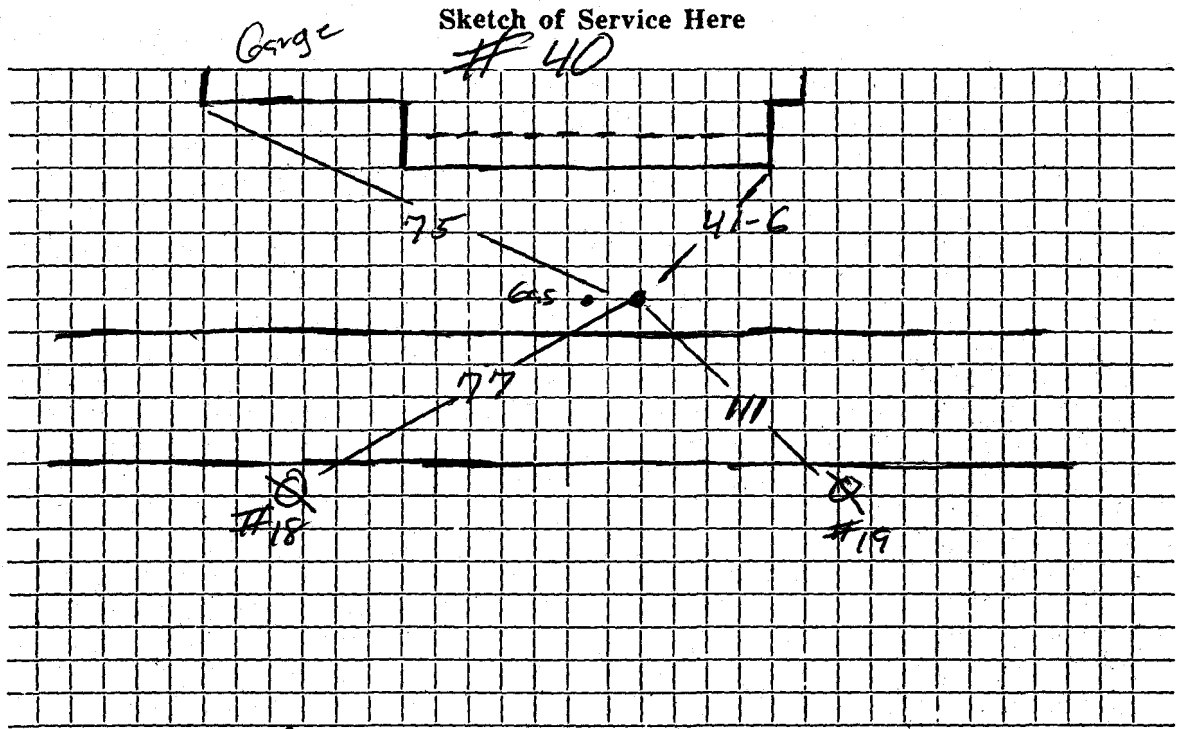

Connection made in Winthrop Rd. Street. Work completed

Remarks: Gas curb 8'6" to the left