

WATER SERVICE RECORD

6104

Name William T. Gill

Service No. 263

Address 42 Winthrop Road

Location

Reason for ~~Renewal~~ New Service

Cam. 10-5-53


Date	Material	Amount	Total	Date	Amount
9/8/53	Labor	12 50		9-1-53	Deposited 25 00
	10% overhead	1 25	13 75	10-5-53	Refunded 16 94
	45' -3/4" copper tubing@.3629		17 06		<u>NON CHARGE</u> 58 06
	1 -3/4"C x 1/2 I.W.H. stop& waste		4 00	9/8/53	Labor 12 50
	3 hrs. Littlefield shovel@ 7.50		22 50		36' - 3/4" copper tubing@.3629 13 06
	1 hr. trucking		75		1 -3/4"C. corp-cock 4 33
			58 06		1 -3/4"C x 3/4"C. curb-cock 4 67
					1 box and rod 3 90
					1 -1/2" straight tail piece 50
					1 -1/2" offset tail piece 50
					2 hrs. Littlefield shovel@ 7.50 15 00
					1 hr. trucking 75
					<u>55 21</u>
				3-30-64	STORAGE IN MAIN

DATE _____

TOWN OF LEXINGTON — BOARD OF PUBLIC WORKS

WATER DIVISION

Sketch of Service Here

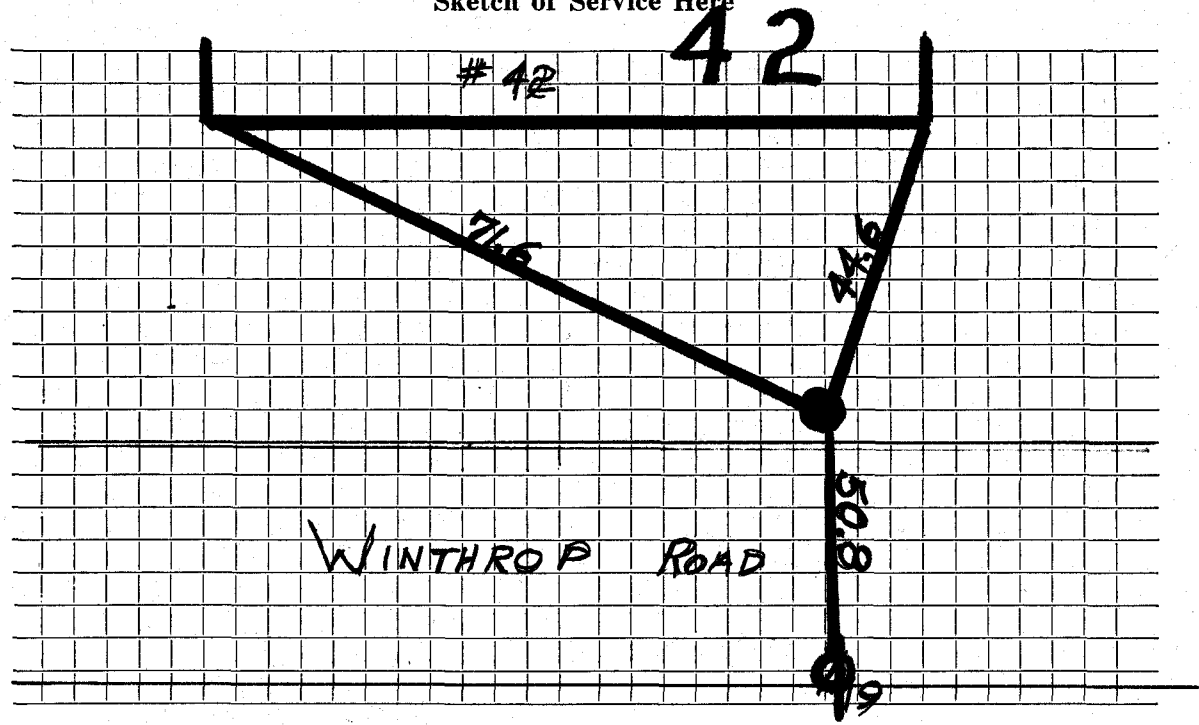

Connection made in Street. Work completed

Remarks:
.....
.....