


DATE Nov 1983

TOWN OF LEXINGTON — BOARD OF PUBLIC WORKS

WATER DIVISION

Sketch of Service Here

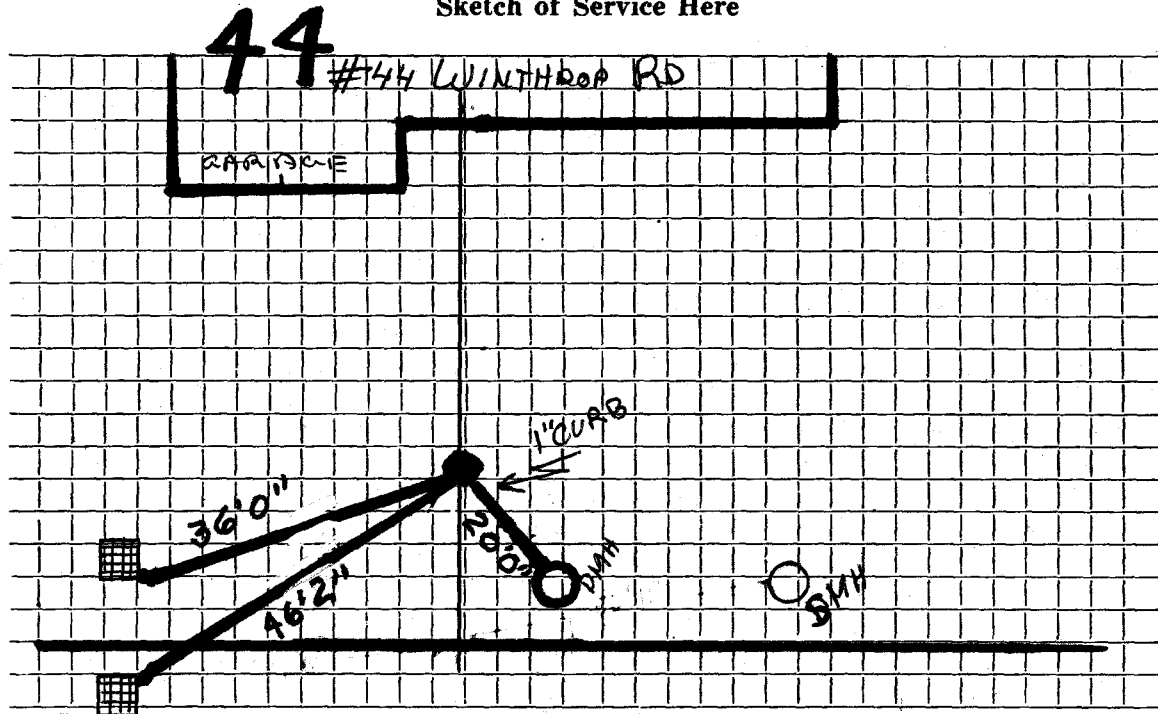

Connection made in C.B. WINTHROP RD Street. Work completed Nov. 18, 1983

Remarks:

.....

.....