

WATER SERVICE RECORD

Name **Hugo Malhenza**Service No. **63**Address **45 Winthrop Road**

Location

~~Work - Service~~ - New Service

Comm 6-19-61

Date	Material	Amount	Total	Date		Amount
5-26-61	Labor	4.30		5-23-61	Deposit	50.00
	10% O.H.	.43	4.73	4-19-61	Retund	12.58
56'	3/4" Copper Tubing @ .42		23.52			37.42
1	3/4" c x 1/2 I.W.H. Stop & Waste	6.17			NON CHARGE	
1	Hr. Trucking @ 3.00		3.00	6-26-61	Labor	4.08
			37.42	12'	3/4" Copper Tubing @ .42	5.04
				1	3/4" C Corp Cook	4.91
				1	3/4" c Curb Cook	6.28
				1	Box & Rod	4.90
				1 1/2	Straight tailpiece	.50
				1 1/2	Offset tailpiece	.50
						26.21


* Apply 11.93 to DHC# 53

DATE _____

TOWN OF LEXINGTON — BOARD OF PUBLIC WORKS

WATER DIVISION

Sketch of Service Here

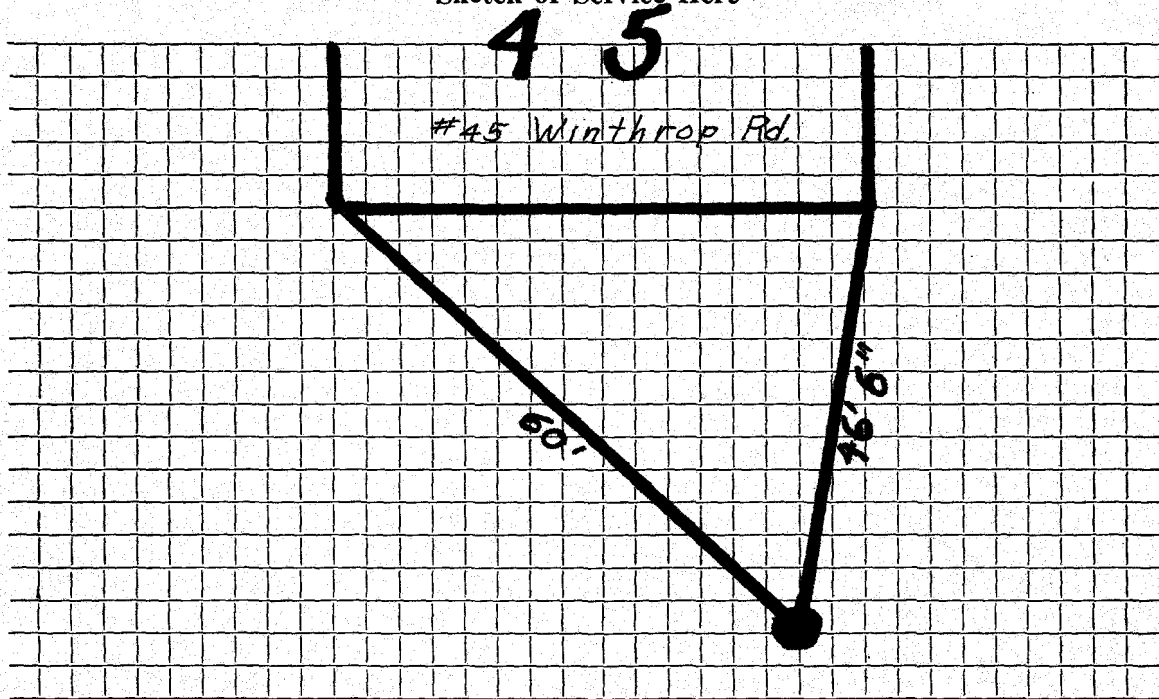

Connection made in Street. Work completed

Remarks:
.....
.....