

WATER SERVICE RECORD

1474  
Service No. 12

Name Alden Johnson

Address 47 Winthrop Road

Location

~~Repair-Renewal~~—New Service


*Committed 4-2-56*

Date	Material	Amount	Total	Date	Amount
2/23/56	Labor	26 60		2-13-56	Deposited \$ 100 00
	10% overhead	2 66	29 26	4-2-56	Refunded 8 28
	14' - 3/4" Copper tubing @ .50		22 00		NON CHARGE 91 72
	1 - 3/4Cx1/2 I.W.H. Stop & Waste		4 96	2/24/56	Labor 26 60
	4 hrs. Littlefield Shovel @ 8.50		34 00		14' - 3/4" Copper tubing @ .50 7 00
	2 hrs. trucking @ .75		1 50		1 - 3/4 C. Corp Cock 4 34
			91 72		1 - 3/4 C. Curb Cock 5 94
					1 Box & rod 4 62
					1 - 1/2 Straight tailpiece 50
					1 - 1/2 Offset tailpiece 50
					4 hrs. Littlefield Shovel @ 8.50 34 00
					1 hr. truck 75
					84 25

DATE \_\_\_\_\_

TOWN OF LEXINGTON — BOARD OF PUBLIC WORKS  
WATER DIVISION

Sketch of Service Here

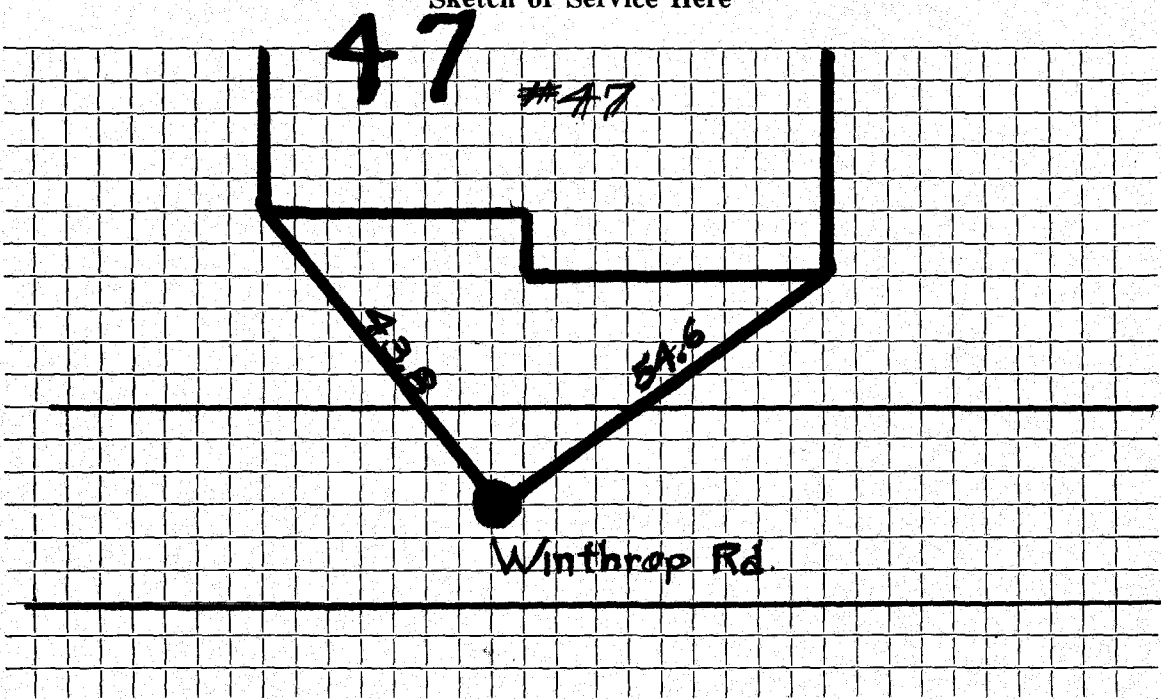

Connection made in ..... Street. Work completed .....

Remarks: .....  
.....  
.....