

WATER SERVICE RECORD

Name Stanley Phalen

Service No. 58

Address 48 Winthrop Road

Location Lexington, Mass.

~~Repair-Renewal~~ - New Service


Com. 8-6-51

Date	Material	Amount	Total	Date	Amount
4-16-51	Labor	1 49	1 49	4-10-51	15 00
	10% Overhead		15	8-17-51	2 95
	40' - 1" Copper Tubing @.43		17 20	8-16-51	2 35
	1 - 1"C x 1" I.W.H. S&W		5 12		23 30
	1 - 1" x 3/4" Red. Bushing		59		No Charge
	Trucking 1 hr. @.75		75	4-16-51	Labor
			25 30	33' - 1" Copper Tubing @.43	14 19
				1 - 1" C Corp-cock	5 15
				1 - 1"C x 1"C Curb-cock	5 60
				1 - Box & Rod	4 68
				1 - 1/2" Straight Tail Piece	50
				1 - 1/2" Offset Tail Piece	50
				Littlefield Shovel 3 hrs. @.7.00	21 00
				Trucking 1 hr. @.75	75
				9-21-60 Repair	59 49
				15' 1" Copper	
				1 1" 3 Part Union	

DATE _____

TOWN OF LEXINGTON — BOARD OF PUBLIC WORKS
WATER DIVISION

Sketch of Service Here

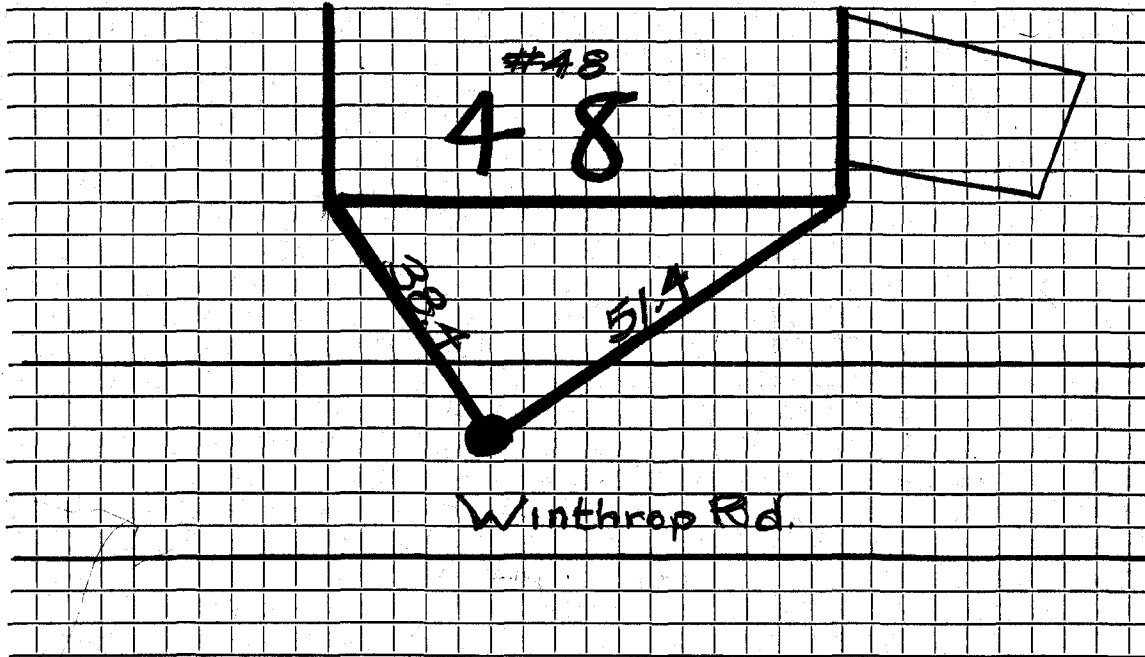

Connection made in Street. Work completed

Remarks:

.....
.....