




DATE 11-3-00

TOWN OF LEXINGTON — BOARD OF PUBLIC WORKS

WATER DIVISION

Sketch of Service Here

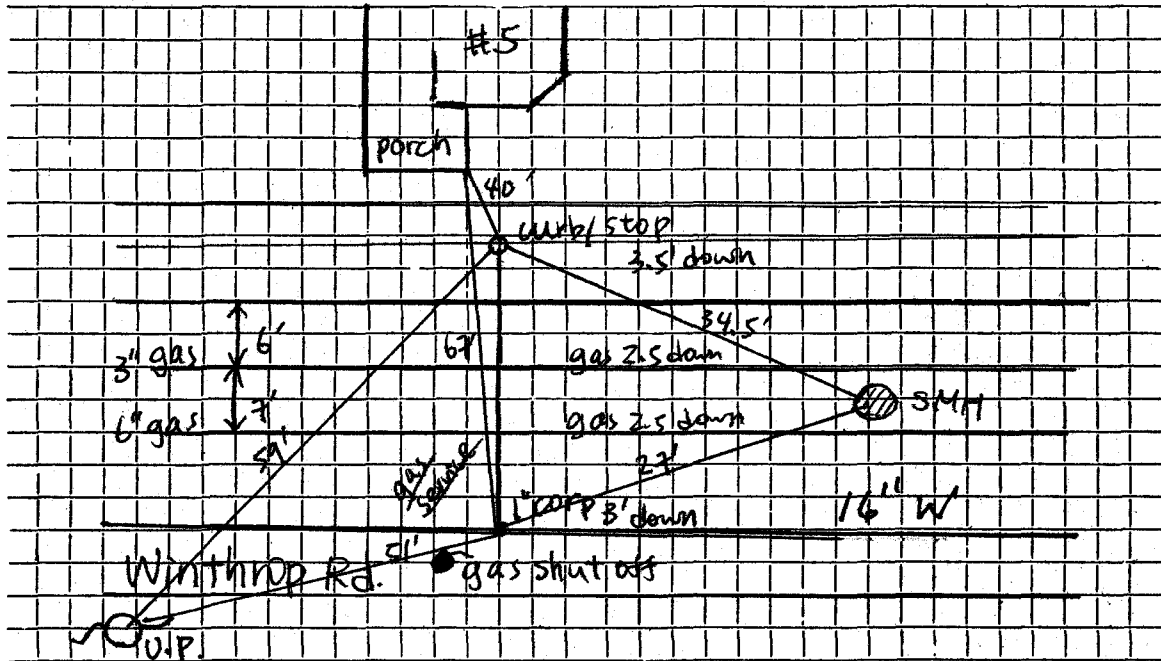

Connection made in ..... Street. Work completed . Granese R.S. & S. Inc. ....

Remarks: .....  
.....  
.....

WATER SERVICE RECORD

Name John R. Nichols

Service No. 66

Address 5 Winthrop Road

Location

~~x Repair~~ - Renewal - ~~New Service~~ x

Comm. 7/22/57

Date	Material	Amount	Total	Date	Amount
4/25/57	Labor	70 38		4-11-57	Deposit \$ 125 00
	10% overhead	7 04	77 42	7-22-57	Refund \$ 12 62
	55' - 1" Copper tubing @ .5202		28 61		NON CHARGE \$ 112 38
	1 - 1" Cx3/4 I.W.H. Stop & Waste		5 60	4/24/57	Labor 11 34
	1 hr. trucking		75		5' - 1" Copper tubing @ .5202 26 01
			112 38		1 - 3/4" G. Corp Cock 4 64
					1 - 3/4" G. Curb Cock 5 94
					1 Box & Rod 4 62
					1-3/4" Straight tailpiece 50
					1-3/4" Offset tailpiece 50
					53 55

