

WATER SERVICE RECORD

Name Ray Dellova

Service No. 137

Address 51 Winthrop Rd.

Location Lexington

~~REPAIR~~ ~~RENEWAL~~ New Service

Cm. 9-22-52


Date	Material	Amount	Total	Date	Amount
8/22/52	Labor	6 62		7-11-52 Deposited	50 -
	10% overhead	66	7 28	9-22-52 Refunded	(7 81)
	45' -3/4" copper tubing@.3439		16 16		<u>NON CHARGE</u>
	1 -3/4" C x 1/2 I.W.H. stop & waste	4 00		8/22/52 Labor	6 62
	2 hrs. Littlefield shovel		14 00	15' - 3/4" copper tubing@ .3439	5 16
	1 hr. trucking		75	1 -3/4" C. corp-cock	4 33
			42 19	1 -3/4" C x 3/4" C. curb-cock	4 67
				1 box and rod	3 90
				1 -1/2 offset tail piece	50
				1 -1/2 straight tail piece	50
				2 hrs. Littlefield shovel	14 00
				1 hr. trucking	75
					<u>40 43</u>

DATE _____

TOWN OF LEXINGTON — BOARD OF PUBLIC WORKS

WATER DIVISION

Sketch of Service Here

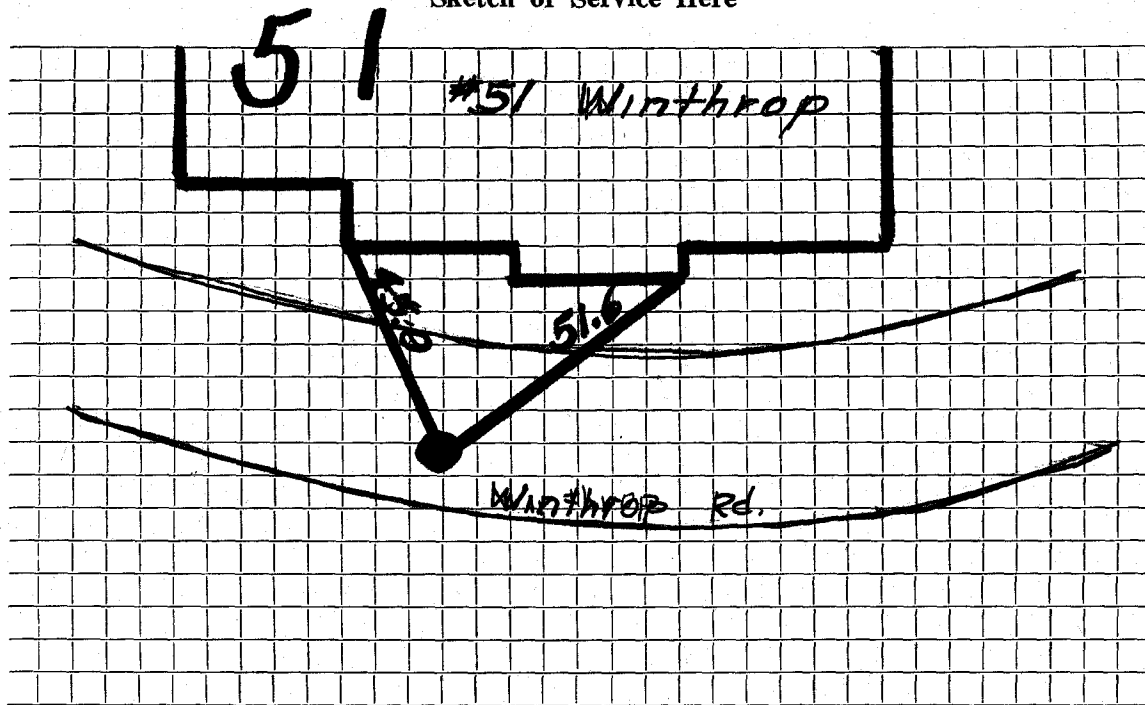

Connection made in Street. Work completed

Remarks:

.....

.....