


DATE July 2001

TOWN OF LEXINGTON — BOARD OF PUBLIC WORKS
WATER DIVISION

Sketch of Service Here

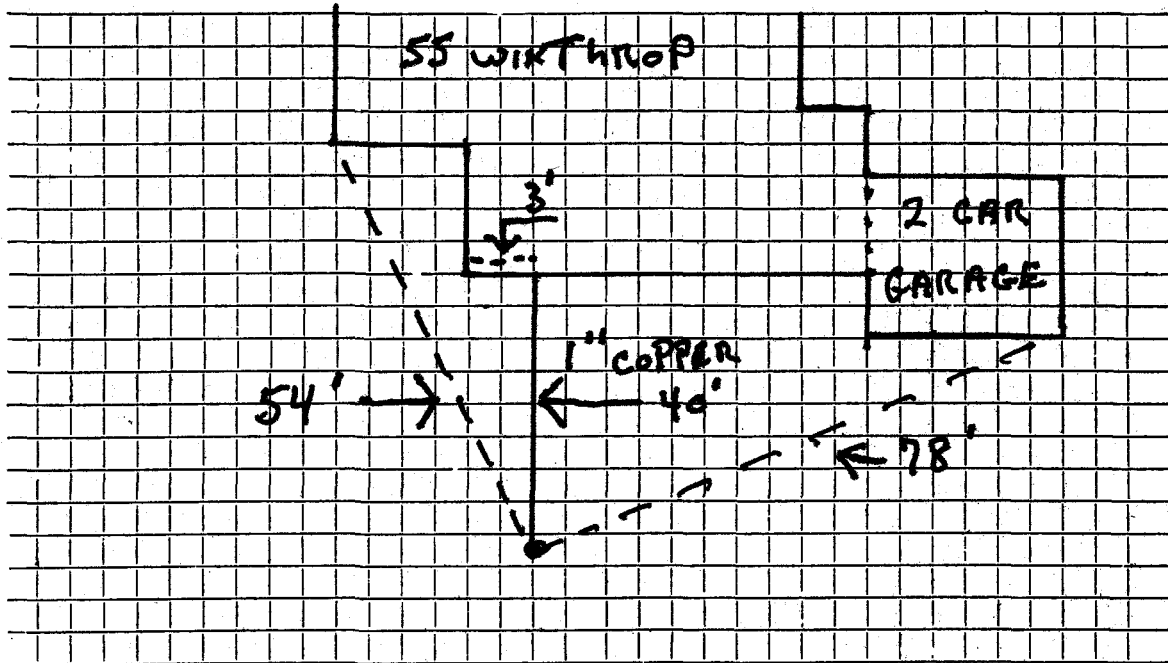

Connection made in wINTHROP.....4th Street. Work completed July...2001.....

Remarks: INSTALLED BY J.M. McLAUGHLIN INC.....