




DATE 11-6-00

TOWN OF LEXINGTON — BOARD OF PUBLIC WORKS

WATER DIVISION

Sketch of Service Here

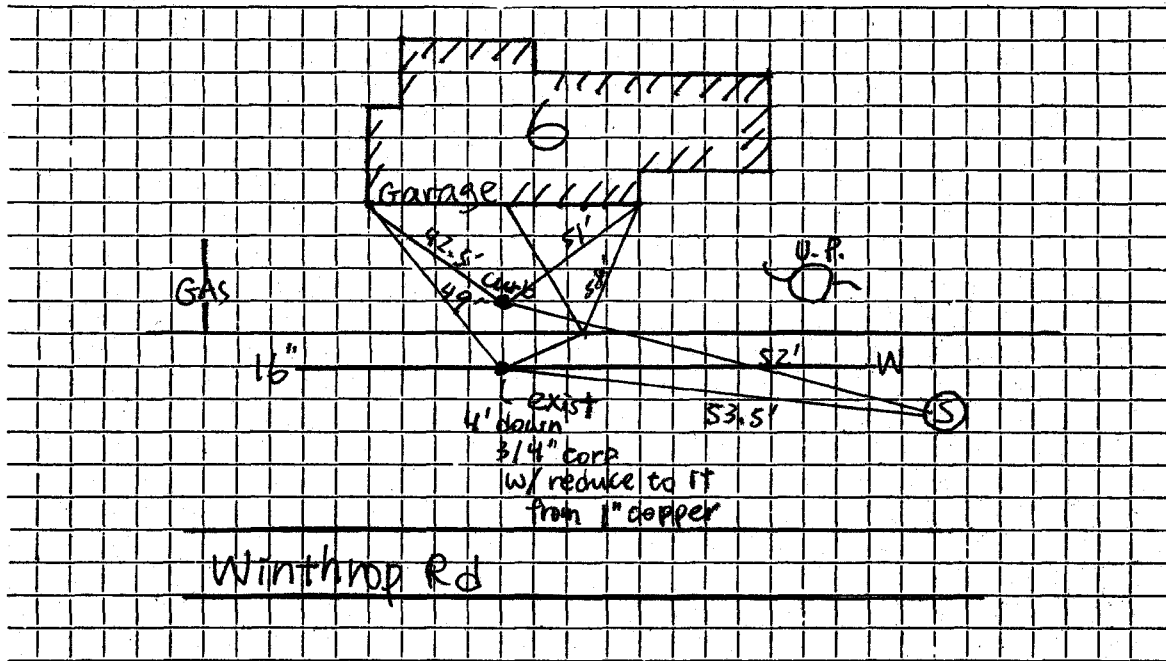

Connection made in ..... Street. Work completed .. Granese & Sons, Inc .....

Remarks: .....  
.....  
.....

**WATER SERVICE RECORD**

Name **Moore Realty Trust**

Service No. **117**

Address **6 Winthrop Road**

# **3385**

Location

~~Previous Service~~ **New Service**

W.O. # **8255**


Comm **2-10-64**

Date	Material	Amount	Total	Date	Material	Amount
11-15-63	Labor	2.31		10-21-63	Deposit	25.00
	10% O.H.	.23	2.54	2-10-64	Returned	50.24
17'	3/4" Copper tubing @.42		7.14			24.26
1	3/4" C x 1/2 I.W.H. Stop & Waste		6.17		NON CHARGE	
1	3/4" C 3 Part union		2.41	11-15-63	Labor	2.05
6 x 3	Patch		6.00	12'	3/4" Copper tubing @.42	5.04
			24.26	1	3/4" C Corp Cock	4.91
				1	3/4" C Curb Cock	6.28
				1	Box & Rod	4.90
				1	1/2 Straight tailpiece	.50
				1	1/2 Offset tailpiece	.50
						24.18

DATE \_\_\_\_\_

**TOWN OF LEXINGTON — BOARD OF PUBLIC WORKS**  
**WATER DIVISION**

Sketch of Service Here

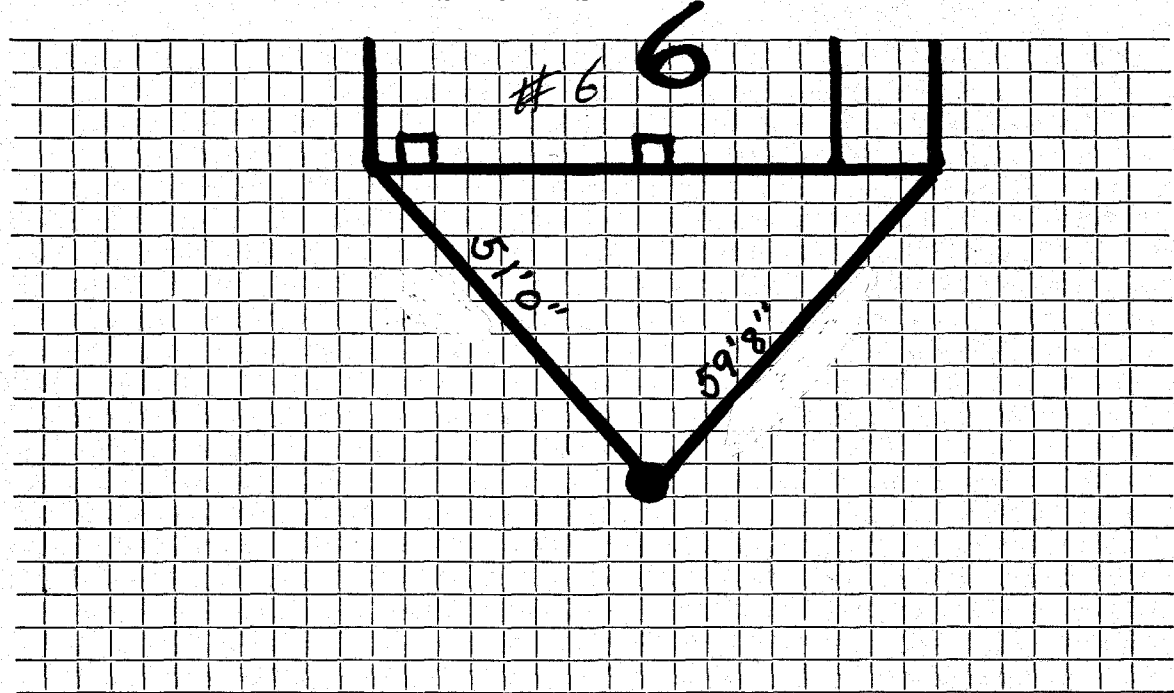

Connection made in ..... Street.      Work completed .....

Remarks: .....  
.....  
.....