




DATE 11-2-00

TOWN OF LEXINGTON — BOARD OF PUBLIC WORKS

WATER DIVISION

Sketch of Service Here

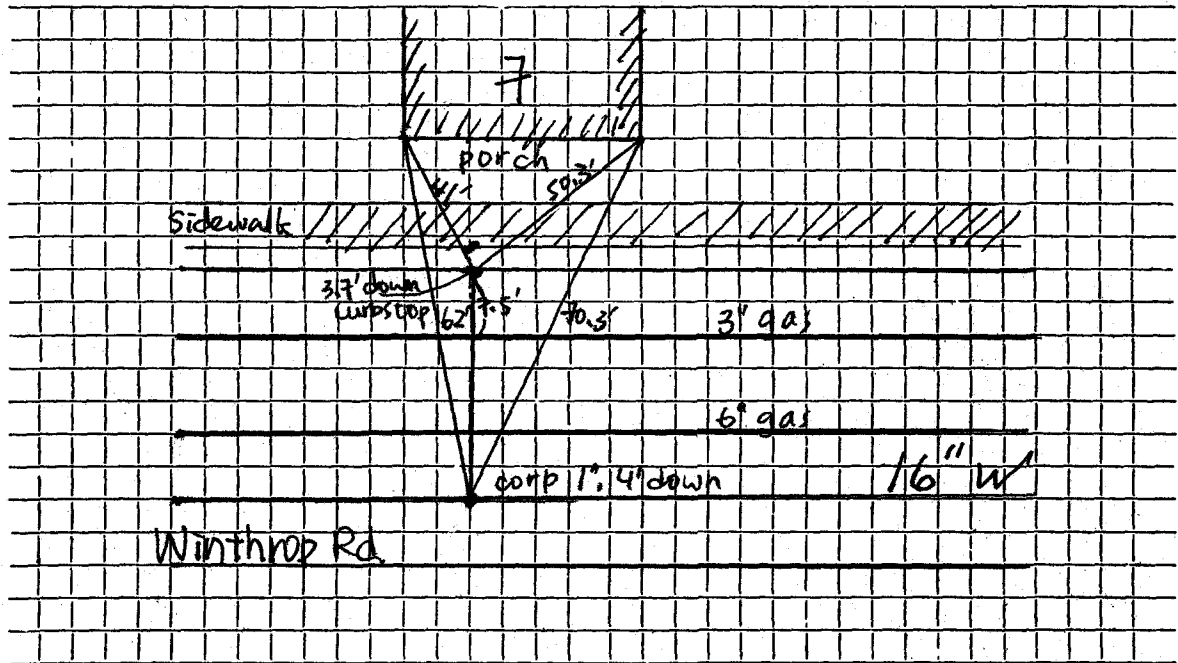

Connection made in ..... Street. Work completed *Granese & Sons, Inc.*.....

Remarks: .....  
.....  
.....

Name Mr. Dana T. Norris

Service No. ~~II~~ 2956

Address 7 Winthrop Road

Lexington 73, Mass.

Location 7 Winthrop Road

Kind of Pipe

Size

Size of Main

~~Repair~~ ~~Renewal~~ ~~New Service~~

Location

Date	Material	Amount	Total	Date	Location	Amount
Sept. 9, '44	Labor	12 10		Sept 8 44	Deposited	50 00
11, '44	"	<u>18 45</u>	30 55	Oct. 19 44	Refunded	16 34
	10% Overhead		<u>3 06</u>		Non-Charge	33 61
			33 61		Labor	6 15
	Furnished copper tubing from house to curb			12' - $\frac{3}{4}$ "	Copper tubing	
				1 - $\frac{3}{4}$ "	C. Curb-cock	
				1 - $\frac{3}{4}$ "	C Corp. Cock	
				Tractor	- 1 hr.	
				Truck	- 1 hr.	
	Labor					

Hadley Press, Inc., Lexington

DATE \_\_\_\_\_

# TOWN OF LEXINGTON—BOARD OF PUBLIC WORKS

## WATER DIVISION

The undersigned applies for a supply of water at No. \_\_\_\_\_ St. and hereby agrees to comply with the rules and regulations as now, or at any future time, established by the Board of Selectmen.


Am't. of Estimate \$ \_\_\_\_\_

Owner \_\_\_\_\_

Am't. Paid \$ \_\_\_\_\_

Address \_\_\_\_\_

Builder \_\_\_\_\_

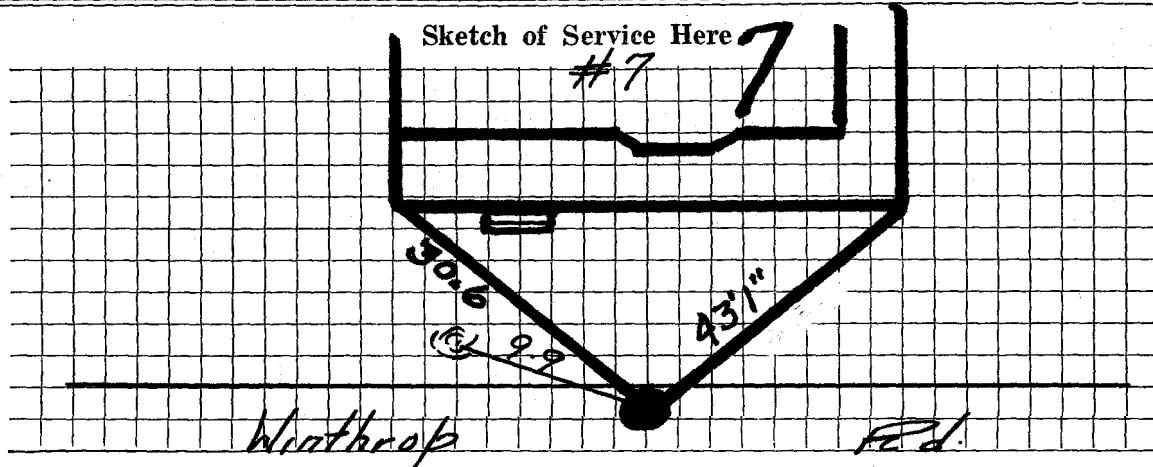

Connection made in \_\_\_\_\_ Street.

Work completed \_\_\_\_\_ 19

Remarks: