




DATE 11-2-00

TOWN OF LEXINGTON — BOARD OF PUBLIC WORKS  
WATER DIVISION

Sketch of Service Here

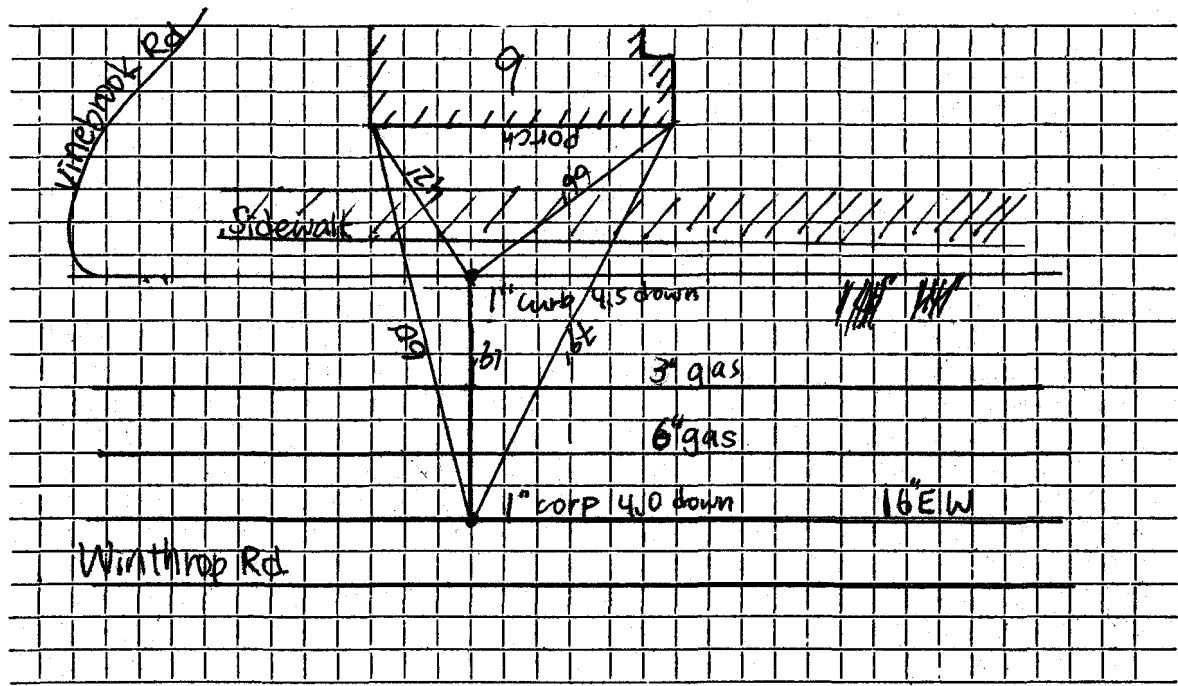

Connection made in ..... Street. Work completed *Granese & Sons, Inc.* .....

Remarks: .....  
.....  
.....

#4328

WATER SERVICE RECORD

Name John B. Rowls

Service No. 87

Address 9 Winthrop Road

Location

~~Repair~~ Renewal ~~New Service~~ W.O. #895

MAR 14 1966


Date	Material	Amount	Total	Date	Amount
8-26-65	Labor 43.44			8-26-65	200 00
8-27-65	" 61.54	104.98		3-14-66	3 75
	10% O.H.	10.50	115.48		196 65
57'	3/4" Copper tubing @.42		23.94		OUTSIDE
1	3/4" Wheel Valve		9.29	8'	3/4" Copper tubing @.42 3.36
4	yds Loam @3.00		12.00	1	box & Rod 4.90
	6 x 3 Patch		6.00	1	Curb Cock 8.76
2	hrs. Town Truck @3.00		6.00	1	Corp Cock 7.41
5	hrs. Town Tractor @6.50		23.94		24.43
			196.65		

DATE \_\_\_\_\_

TOWN OF LEXINGTON — BOARD OF PUBLIC WORKS

**WATER DIVISION**

Sketch of Service Here

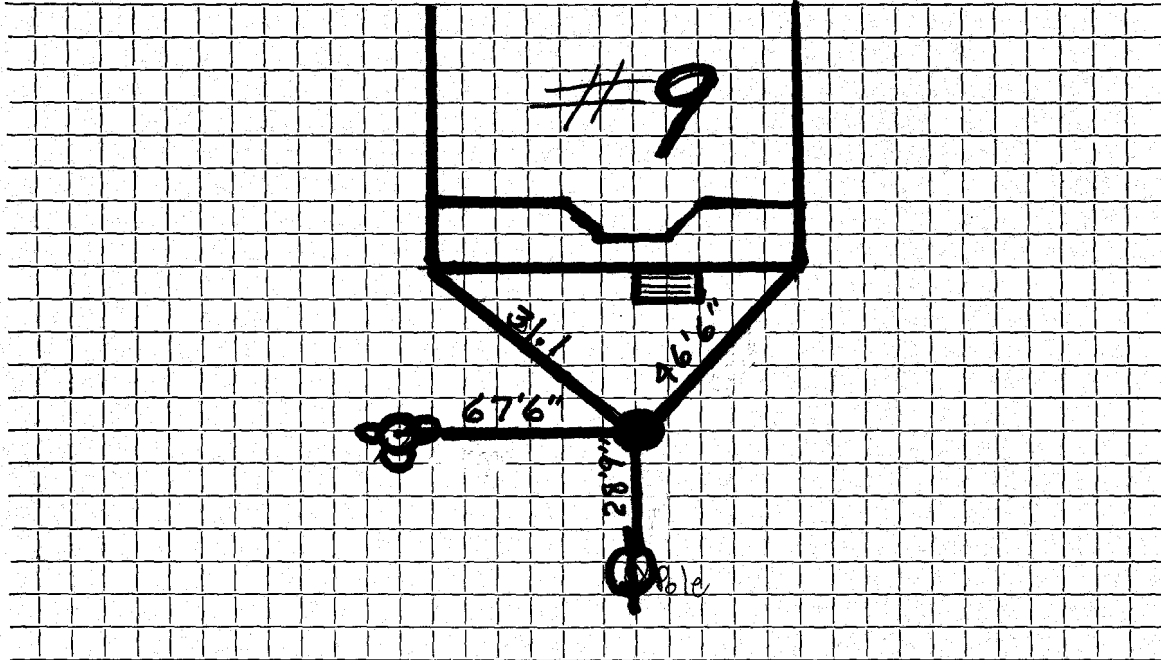

Connection made in ..... Street. Work completed .....

Remarks: .....  
.....  
.....