


DATE _____

TOWN OF LEXINGTON — BOARD OF PUBLIC WORKS

WATER DIVISION

Sketch of Service Here

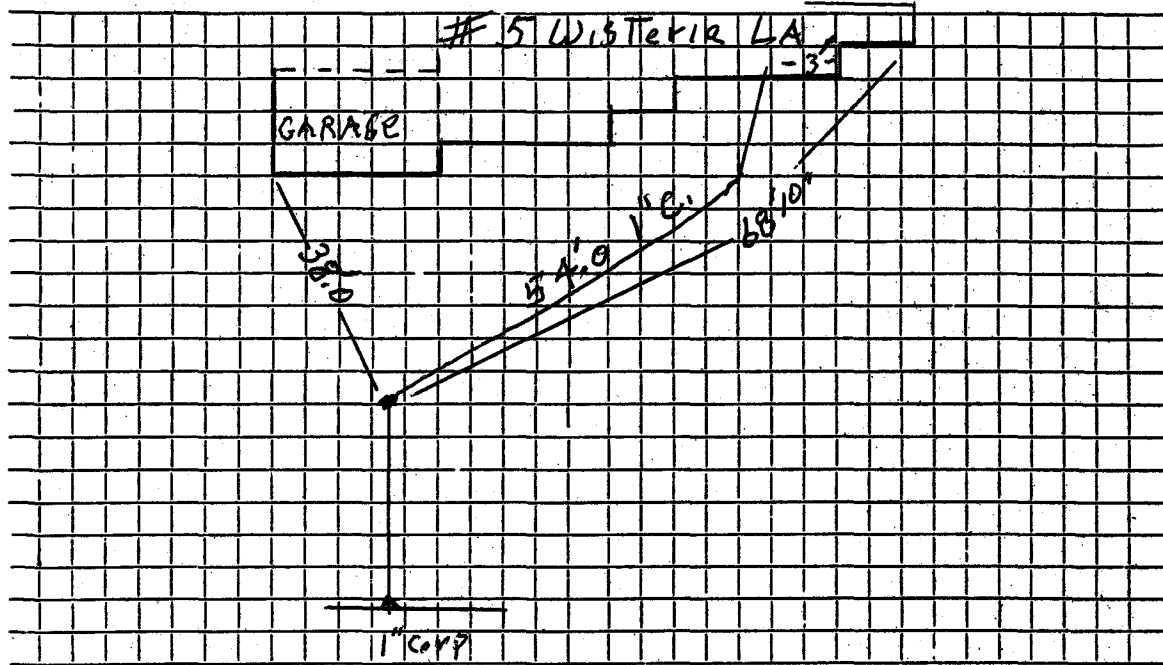

Connection made in Street.

Work completed (IN. SIDE) J. McLaughlin 1/11/07.

Remarks:
.....
.....