


DATE _____

TOWN OF LEXINGTON — BOARD OF PUBLIC WORKS

WATER DIVISION

Sketch of Service Here

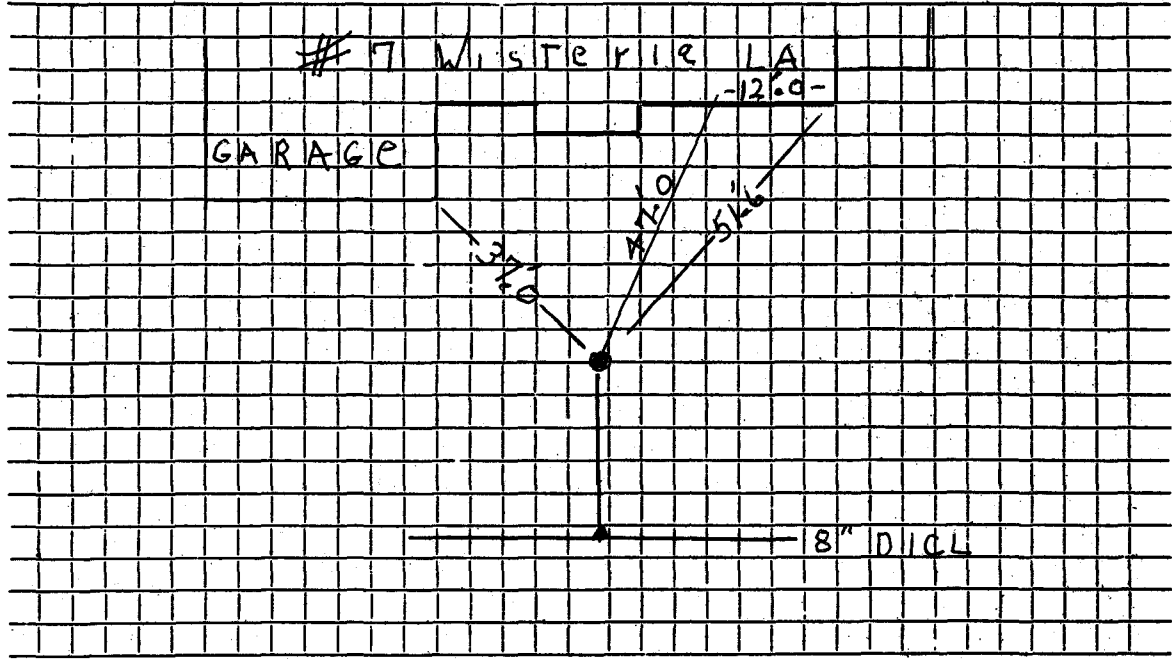

Connection made in Street. Work completed ... 4/19/07, J. McLaughlin ...

Remarks: NO info for outside - no
.....
.....